

**WATER SERVICE RECORD**

Name

Service No.

Address *19 DEXTER RD*

Location


Repair—Renewal—New Service

Date	Material	Amount	Total	Date		Amount
<i>6/7/90</i>	<i>45 LF 3/4" COPPER</i>					
	<i>3/4" COUPLING</i>			<i>6/14/90</i>	<i>3/4 Copper</i>	
					<i>1- 3/4 Corp Bsp</i>	
					<i>1- 3/4 Corp Curb</i>	

DATE \_\_\_\_\_

TOWN OF LEXINGTON — BOARD OF PUBLIC WORKS  
**WATER DIVISION**

Sketch of Service Here

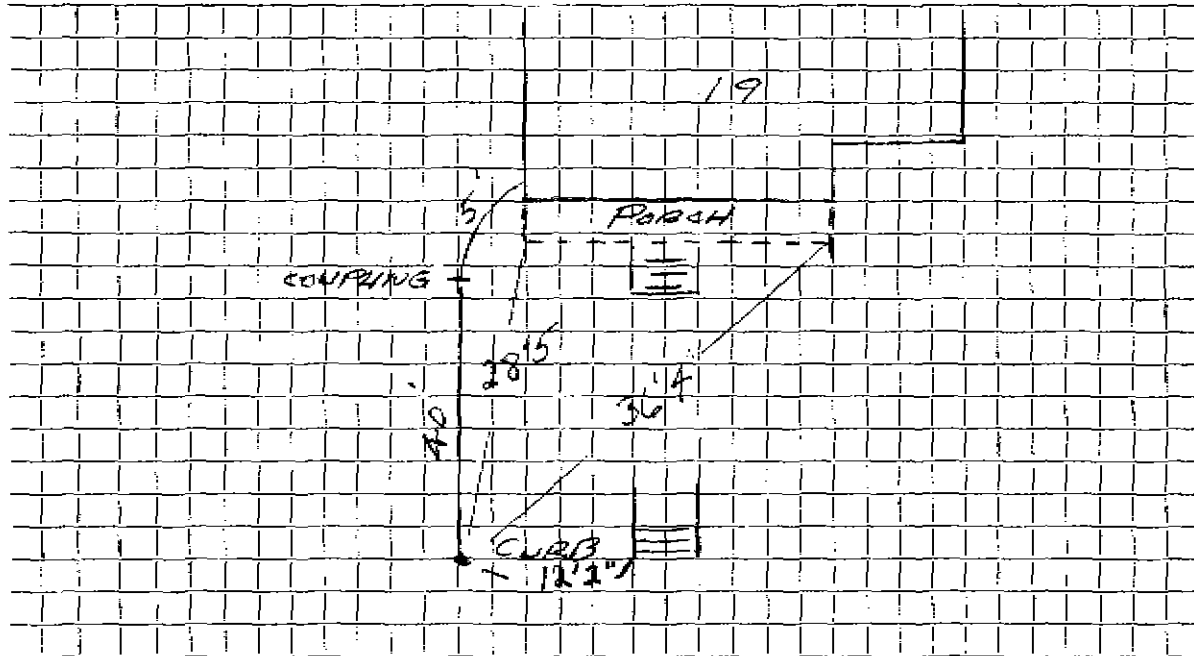

Connection made in DEXTER RD. Street. Work completed .....

Remarks: CONNECT NEW COPPER TO EXIST. CURB  
SAME TIES