WATER SERVICE RECORD


| Name KENNETH WARLAND | | | | | Service No. | | | | | |
|----------------------|---------------------|----------------------|---------------------------------------|-------------------|--------------------|-------------------|---|--|--------------------|--|
| Ado | iress | 22 BEXTER RD | | | | | | | | |
| | ation | | | | | | | | | |
| Rep | air—R | enewal—New Service 🕡 | ENEWAL | | | | | | | |
| Date | | Material | Amount | Total | Date | | | Amount | | |
| 4/2 | 96 | 34.4' OF 314" COPPER | | | 5-17- | 95 | | | | |
| | | | | | | 10'6 | "-34" Copper 34"C. 3 Part 4 34"C. XI" Iron Ac | | | |
| | <u> </u> | | | | !! | | 34"C. 3 Part 4 | NION | | |
| | | | | · | | | 34"C. X1" Iron Ac | apter | ļ | |
| | <u> </u> | <u> </u> | | ! | | ļi | <u> </u> |) | | |
| | │ -} | į | | ļ | 1) | | | \ \ | <u> </u> | |
| - | - | | | ` | | ļ | \ | └ ├ |) | |
| | - | <u> </u> | · - | <u> </u> | ,, | \ | \ | ' |) | |
| | | | | | |) | 1 | ' i | ! | |
| | <u> </u> | | | <u> </u> | |) | · | <u> </u> | ' | |
| | - | ! | <u> </u> | | ···· | ! { | | <u> </u> | ' | |
| | ! - | ' | <u> </u> | <u> </u> | | | <u> </u> | <u> </u> | | |
| - | `\ - } | ! | "! | <u> </u> | | <u> </u> | <u> </u> | <u> </u> | | |
| | 4 | <u> </u> | <u> </u> | ļ | | <u> </u> | | ╎ ╆╾╌╾╴╌╾┐ | ! - | |
| | | | · · · · · · · · · · · · · · · · · · · | | | \ | | · | ' | |
| | | | | | ∬ - | \ ├─╾── | | | <u> </u> | |
| - | ' | ! | | <u> </u> | \\ | 1 | | , , | ! _ | |
| | 1 | | ι. | . 1 | 11 | | I | 1 | | |

DATE 4/2/96

TOWN OF LEXINGTON - BOARD OF PUBLIC WORKS

WATER DIVISION

Sketch of Service Here

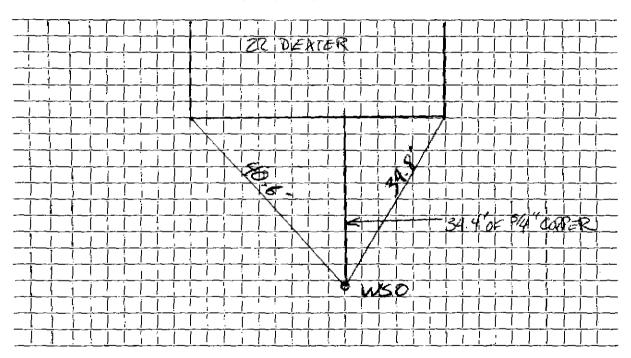

| Connection made in S | treet. W | Vork completed |
|----------------------|----------|----------------|
| Remarks: | | |
| | | |
| | | |