

Name George McMullen

Service No.

2382

Address 28 Dexter Road

Lexington, Mass.

Location 28 Dexter Road

Kind of Pipe

Size

Size of Main

~~Repair~~ ~~Renewal~~ New Service

Com. 7-5-49

Location

Date	Material	Amount	Total	Date	Material	Amount
May 31, '49	Labor	1 35	1 35	May 23 '49	Labor	15 00
	10% Overhead		14	July 6 '49	Expended	2 03
	31' - 3/4" Copper Tubing @.24	7 44	7 44		Non-Charge	12 97
	1 - 3/4" C x 1/2" I.W.H. S&W	3 29	3 29	May 31, '49	Labor	1 35
	Trucking 1 hr. @.75		75	29' - 3/4" Copper Tubing @.24		6 96
			12 97	1 - 3/4" C Corp-cock		3 15
				1 - 3/4" C x 3/4" C Curb-cock		3 85
				1 - Box & Rod		3 95
				1 - 1/2" Offset Tail Piece		37
				1 - 1/2" Straight Tail Piece		37
				Trucking 1 hr. @.75		75
						20 75
	Labor					

TOWN OF LEXINGTON - BOARD OF PUBLIC WORKS

WATER DIVISION

The undersigned applies for a supply of water at No..... St. and hereby agrees to comply with the rules and regulations as now, or at any future time, established by the Board of Selectmen.

Am't of Estimate \$.....

Owner


Am't Paid \$.....

Address

Builder

.....

Sketch of Service Here

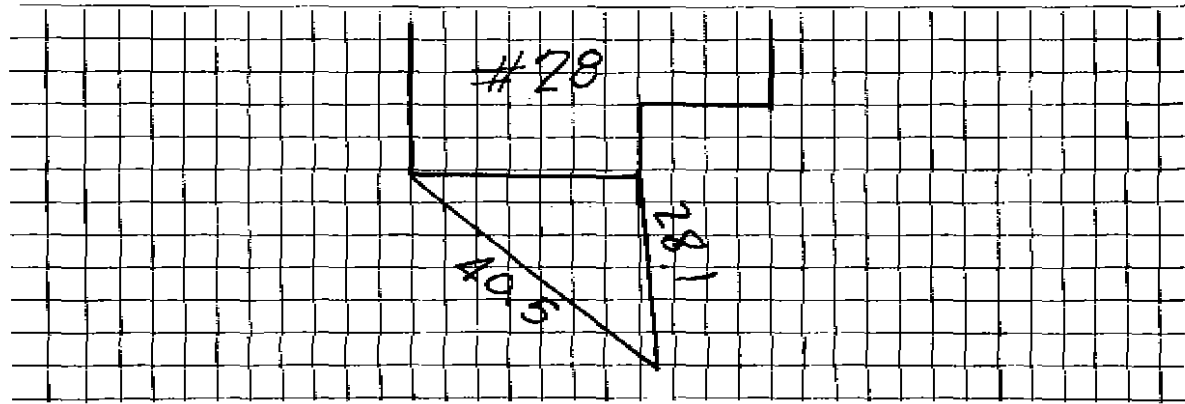

Connection made in Street.

Work completed19

Remarks: