

Name James L. Grant
 Address 29 Dexter Road
 Lexington, Mass.

Service No.

1847

Location 29 Dexter Road

Kind of Pipe

Size

Size of Main

~~Repair~~ ~~Renewal~~ ~~New Service~~

Location

Date	Material	Amount	Total	Date	Location	Amount
Nov. 22, '48	Labor	1 15	1 15	Oct 30 '48	Departed	20 00
	10% Overhead		12	Dec 31 '48	Departed	5 00
	38' - 3/4" Copper Tubing @ .255	9 69	9 69		Non-Charge	14 86
	1 - 3/4" C x 3/4" I.W.H. S & "	3 15	3 15	Nov. 22, '48	Labor	1 15
	Trucking 1 hr. @ .75		75		7' - 3/4" Copper Tubing @ .255	1 79
			14 86		1 - 3/4" C Corp-cock	3 00
					1 - 3/4" C x 3/4" Curb-cock	3 68
					1 - Box & Rod	3 55
					1 - 1/2" Offset Tail Piece	30
					1 - 1/2" Straight Tail Piece	30
					Trucking 1 hr. @ .75	75
						14 52
	Labor					

TOWN OF LEXINGTON - BOARD OF PUBLIC WORKS

WATER DIVISION

The undersigned applies for a supply of water at No..... St. and hereby agrees to comply with the rules and regulations as now, or at any future time, established by the Board of Selectmen.

Am't of Estimate \$.....


Owner

Am't Paid \$.....

Address

Builder

Sketch of Service Here

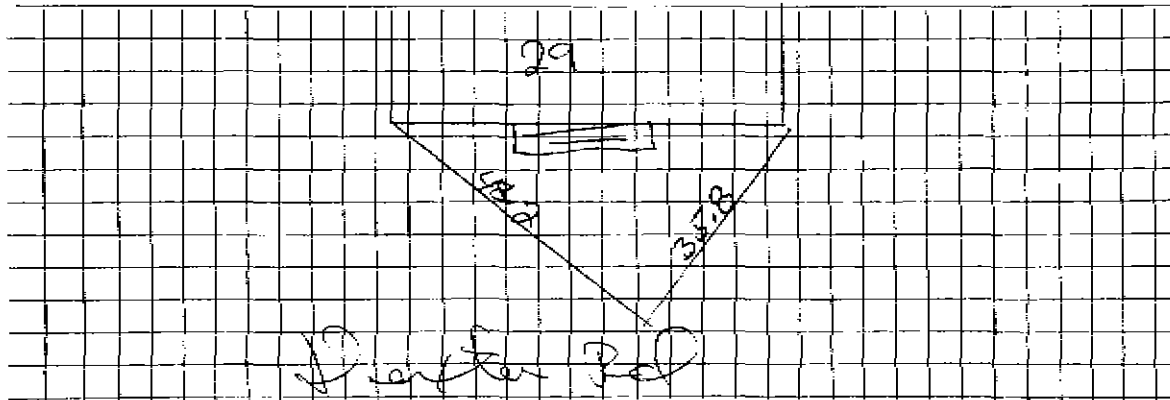

Connection made in Street.

Work completed19

Remarks: