

WATER SERVICE RECORD

7907

Name Bernard Maloney

Service No. 145

Address 30 Dexter Road

H7597

Location (741 Summer St., Arlington)

~~Repair~~ ~~Renewal~~ - New Service

Comm 12-4-61


Date	Material	Amount	Total	Date	Amount
10/9/61	Labor	2 04		10-2-61	50 00
	10% O.H.	20	2 24	12-4-61	6 95
	71 3/4" Copper Tubing @ .42		29 82		43 05
	1 3/4" Cx 1/2 IWH Stop & Waste		6 17		
	2 3/4" C3 part Unions @ 2.41		4 82	10/9/61	Labor 1 84
			43 05		28 3/4" Copper Tubing @ .42 11 76
					1 3/4" C Corp Cock 4 91
					1 3/4" Curb Cock 6 28
					1 Bow & Rod 4 90
					1 1/2 Straight Tailpiece 50
					1 1/2 Offset Tailpiece 50
					30 69

DATE _____

TOWN OF LEXINGTON — BOARD OF PUBLIC WORKS

WATER DIVISION

Sketch of Service Here

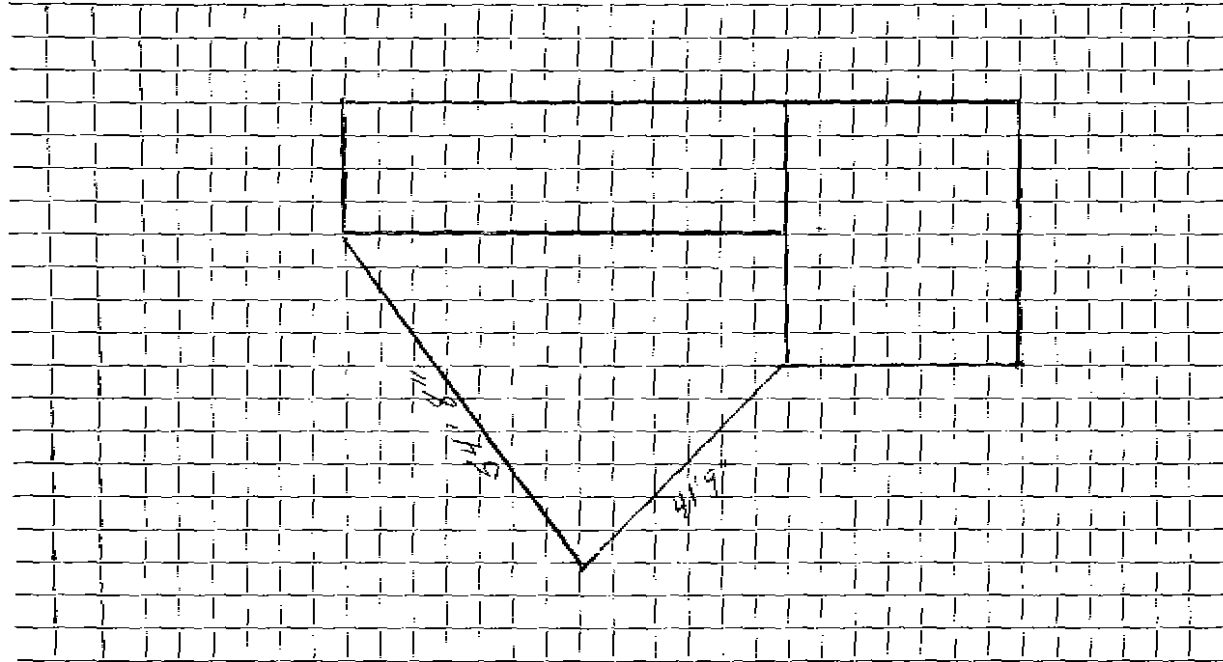

Connection made in Street. Work completed

Remarks:
.....
.....