




DATE 5/30/95

TOWN OF LEXINGTON — BOARD OF PUBLIC WORKS

WATER DIVISION

Sketch of Service Here

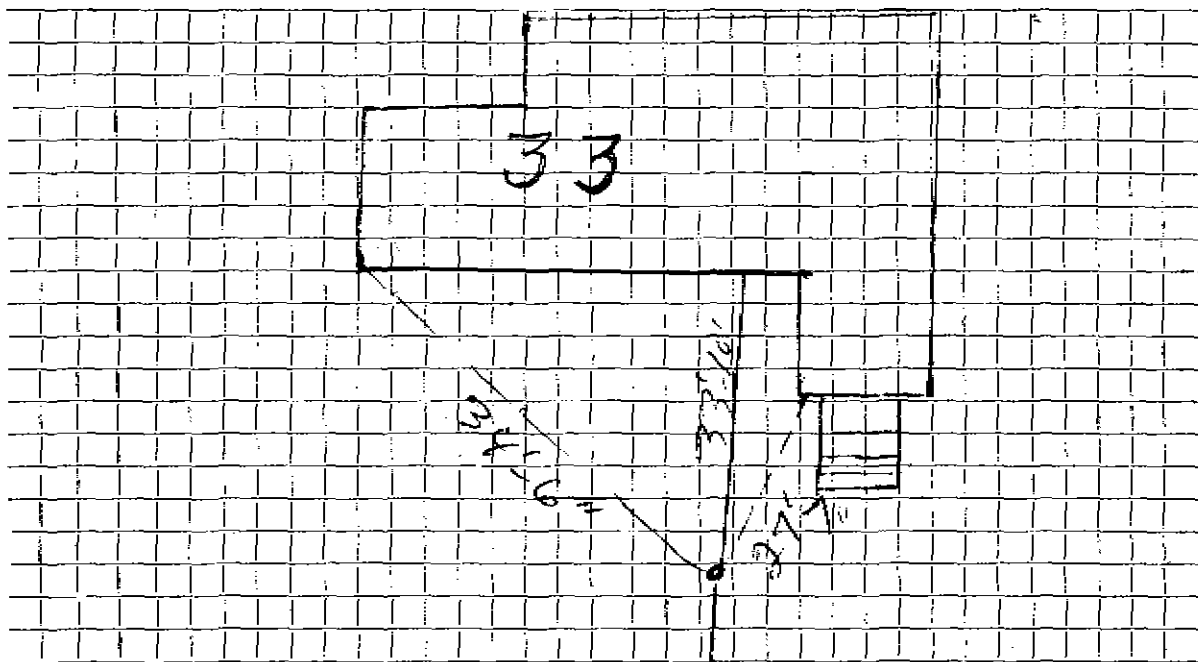

Connection made in Dexter Street. Work completed 5/30/95

Remarks: BRUCE J. MCKEE