

Name Ida M. Maclaren

Service No. ~~49~~ 735

Address 37 Dexter Road

Location

Kind of Pipe

Size

Size of Main

~~Repair - Renewal~~ - New Service

Location

Date	Material	Amount	Total	Date	Amount
	34 1" C.L. Pipe @ .27	9 18			
	2 1" L.L. Coups @ .30	60			
	1 1" L.L. Elbs	35			
	1 1" Br. Sp. Nipple	25			
	1 S & W	3 00			
	Trucking	75	14 13		
6/15/29	15 Hrs. Labor @ .55	8 25			
	2 " " @ .60	1 20	9 45		
	15% Overhead		1 42		
			25 00		
	Labor				

June 13 1929 - Cash 17 ✓
 Aug 5 - 29 " 8 ✓

 25 ✓

Hudley Press, Inc., Lexington

DATE June 13, 1929

TOWN OF LEXINGTON—BOARD OF PUBLIC WORKS

WATER DIVISION

The undersigned applies for a supply of water at No. ^{Lots #37} 37438, Dexter Rd. St. and hereby agrees to comply with the rules and regulations as now, or at any future time, established by the Board of Selectmen.

Am't. of Estimate \$ _____

Owner

Ida M. MacLaren

Am't. Paid \$ 1.77


Address

Dexter Rd.

Builder _____

Lexington Mass.

Sketch of Service Here

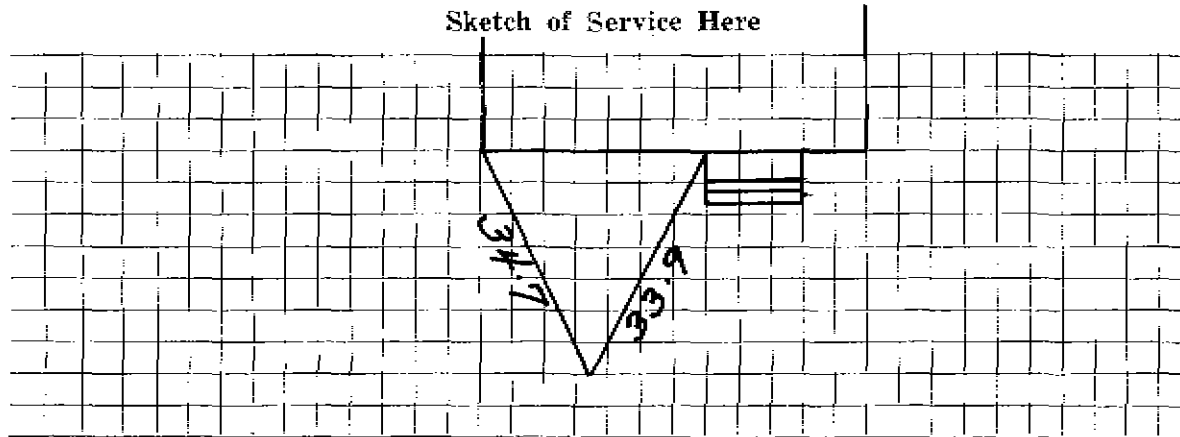

Connection made in _____ Street.

Work completed _____ 19

Remarks: