

WATER SERVICE RECORD

Name Donna Realty Trust

Service No. 41

Address #38 Dexter Road

Location

Repair—Renewal—New Service *WO# 7123* Valeri Construction #1123


NOV 18 1968

Date		Material	Amount		Total		Date	Amount
8/1/68	40'	3/4" Copper Tubing					7-23-68	260 00
7/31/68		Labor	11.70				11-18-68	156 20
		10% O.H.	1.17	12.87	12.87			103 30
	36'	3/4" Copper Tubing			28.44			
	1	3/4" Curb Cock			11.32			
	1	3/4" Corporation			9.57			
	1	Box & Rod			5.10			
	1	Hr. Trucking			3.00			
		Patching			33.00			
					103.30			
8/1/68	40'	3/4" Copper tubing						
								S/C# 33 (14.20) S/C# 31 (37.68)
								S/C# 110 (52.82) S/C# 188 (33.35)
								W/C# (18.65)

DATE _____

TOWN OF LEXINGTON — BOARD OF PUBLIC WORKS

WATER DIVISION

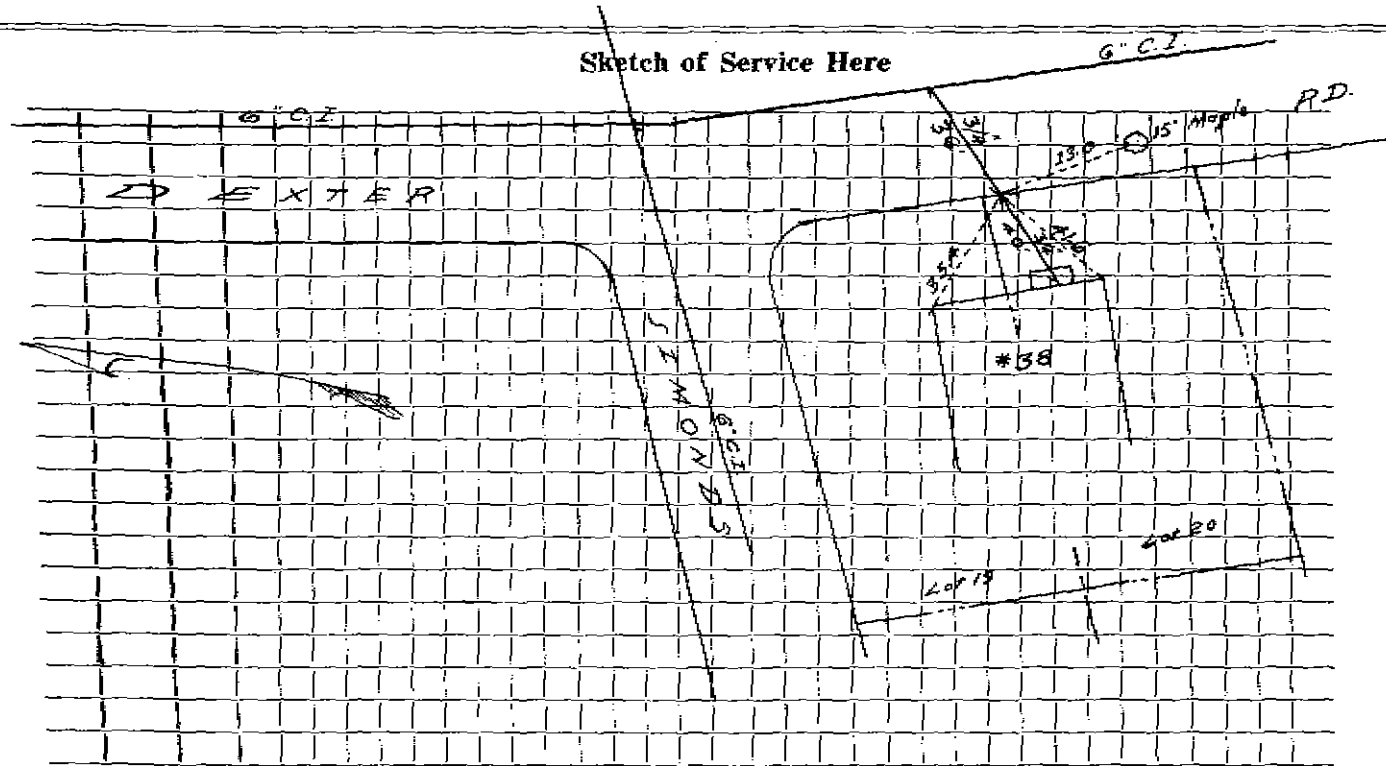

Connection made in _____ Street. Work completed _____

Remarks: _____
