


DATE _____

TOWN OF LEXINGTON — BOARD OF PUBLIC WORKS

WATER DIVISION

Sketch of Service Here

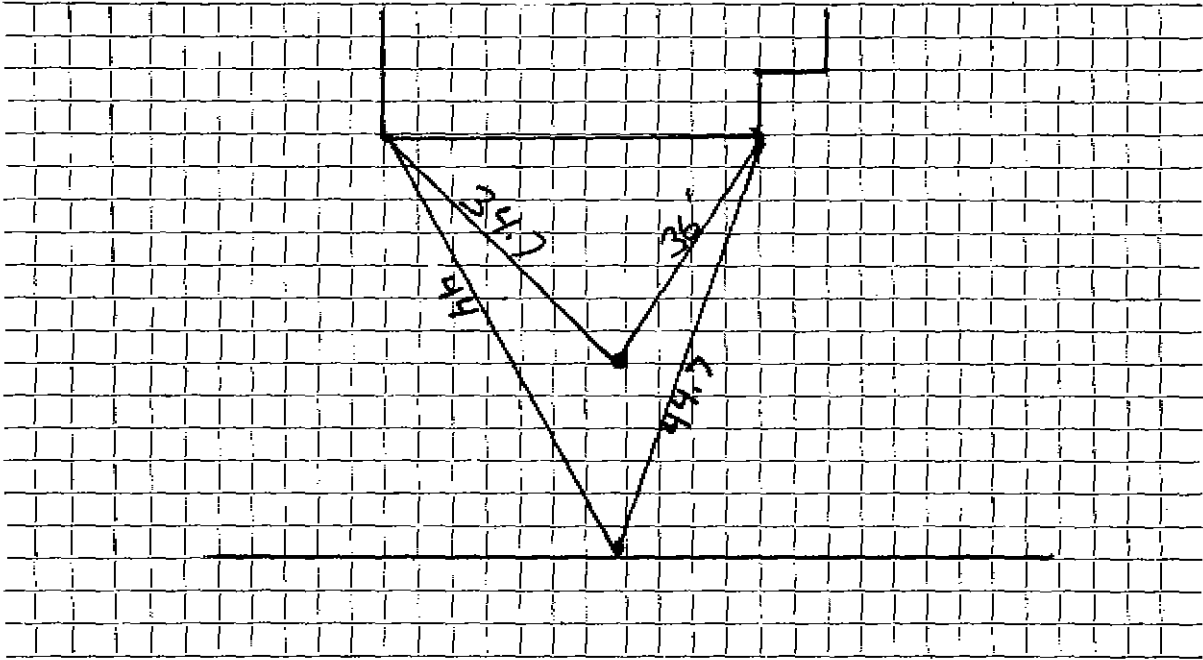

Connection made in Street. Work completed 5-12-93

Remarks: Corp. 4.3 deep Curb 4' deep

.....
.....