


Water Service Tie Card
TOWN OF LEXINGTON
 MASSACHUSETTS

53 Dexter Rd

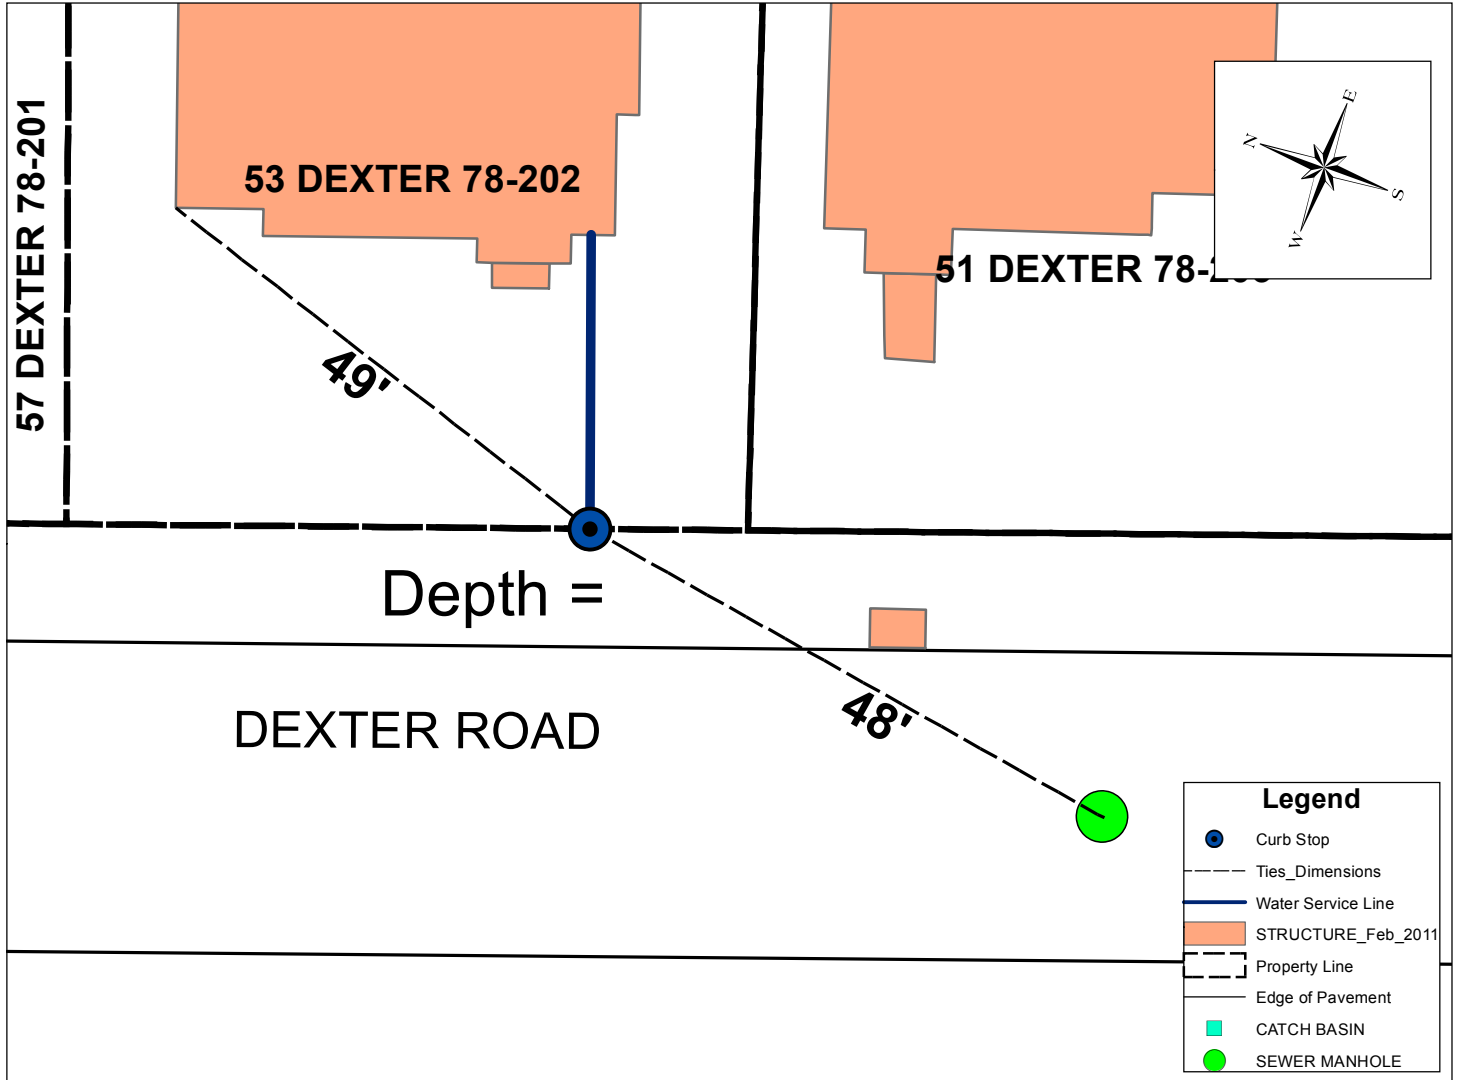

Address	Map and Lot	Permit Number	Contractor Name	Inspector
53 Dexter Rd	78-202	5881	McLaughlin, James M. Inc.	msprague
Date	Material	Depth of Cover	Amount	
9/15/2014	Corporation	5 ft	1	
	1" Curb Valve and Buffalo Box	4 ft	1	
	1" Copper type "k"		25.5 ft to HSE	
Type of work completed				
Repair and replace water line from house to curb and to main.				