

Name George H. Bowen

*Check from: W. R. Richardson
16 Meridian St.
Melrose.*

Service No. ~~1158~~ **739**

Address 18 Quincy St., Medford Hillside
57 Dexter Road

Location 57 Dexter Road

Kind of Pipe Size Size of Main
Repair—Renewal—New Service Location

Date	Material	Amount	Total	Date	Amount
1940					
Aug. 12,	4 hrs. @ 60¢	2 40		August 1, 1940	25.00
<i>Com 9/30/40</i>	10% Overhead	<u>24</u>	2 64	October 2, 1940	<u>674</u>
	33' 3/4" Copper tubing @	182	3 94		1826
	2 3/4" C.x 1/2" I.S. & W.		2 25		
	1 hr. trucking		75		
	Trench repairs		<u>6 68</u>		
			18 26		
	Labor				

Hadley Press, Inc., Lexington

DATE July 30-40

TOWN OF LEXINGTON—BOARD OF PUBLIC WORKS

WATER DIVISION

The undersigned applies for a supply of water at No. 57 Dexter Rd. St. and hereby agrees to comply with the rules and regulations as now, or at any future time, established by the Board of Selectmen.

Am't. of Estimate \$ _____

Owner George H Bowen


Am't. Paid \$ _____

Address 57 Dexter Rd.

Builder W.R. Nisheron

(18 Quinway St.
Medford Hillside)

Sketch of Service Here

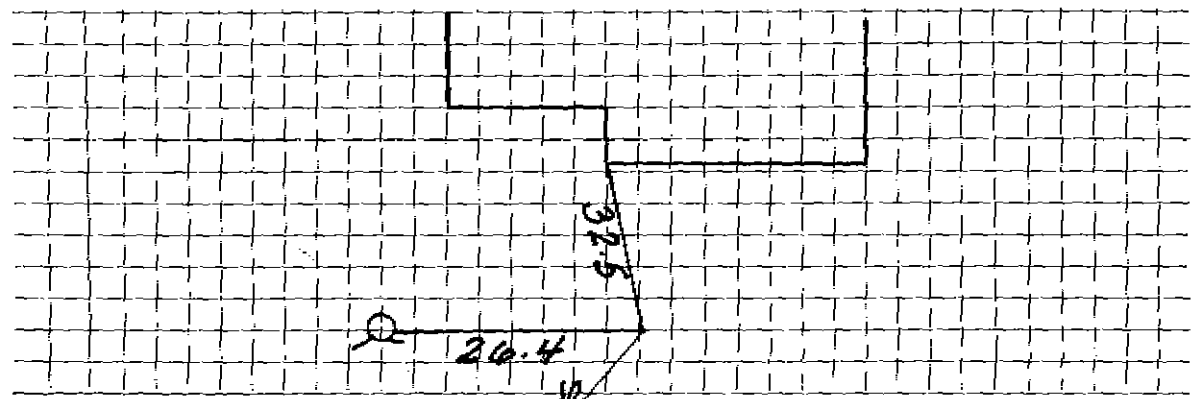

Connection made in _____ Street.

Work completed _____ 19

Remarks: