

Name

Service No. 740

Address 58 Dexter Rd.

390

Location 58 Dexter Rd.

391

Kind of Pipe

Size

Size of Main

Repair—Renewal—New Service

Location

Date

Material

Amount

Total

Date

Amount

Labor

DATE _____

TOWN OF LEXINGTON—BOARD OF PUBLIC WORKS

WATER DIVISION

The undersigned applies for a supply of water at No. _____ St. and hereby agrees to comply with the rules and regulations as now, or at any future time, established by the Board of Selectmen.

Am't. of Estimate \$ _____

Owner

J. McCormick


Am't. Paid \$ _____

Address

~~62~~ Dexter Rd.
58

Builder _____

Sketch of Service Here

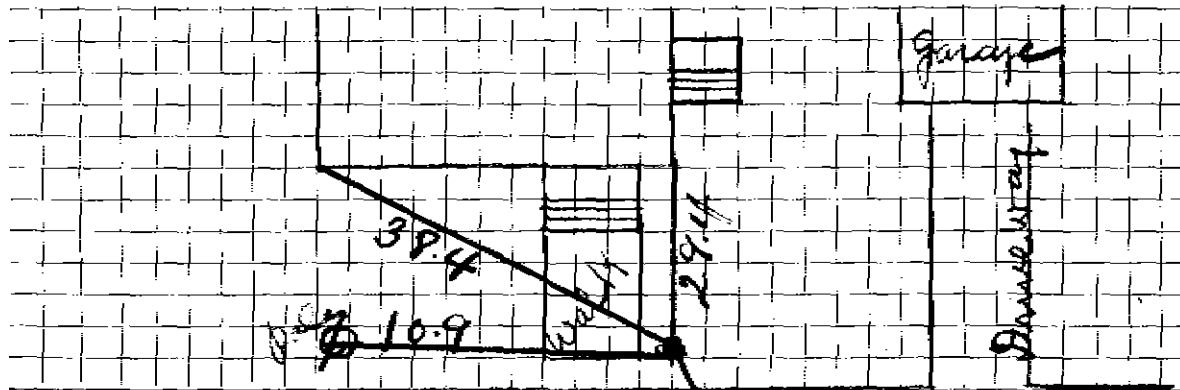

Connection made in Dexter Rd Street. Work completed _____ 19

Remarks:

4080
Hyd