




DATE 11-19-'90

TOWN OF LEXINGTON — BOARD OF PUBLIC WORKS  
WATER DIVISION

Sketch of Service Here  
# 6 DEXTER ROAD

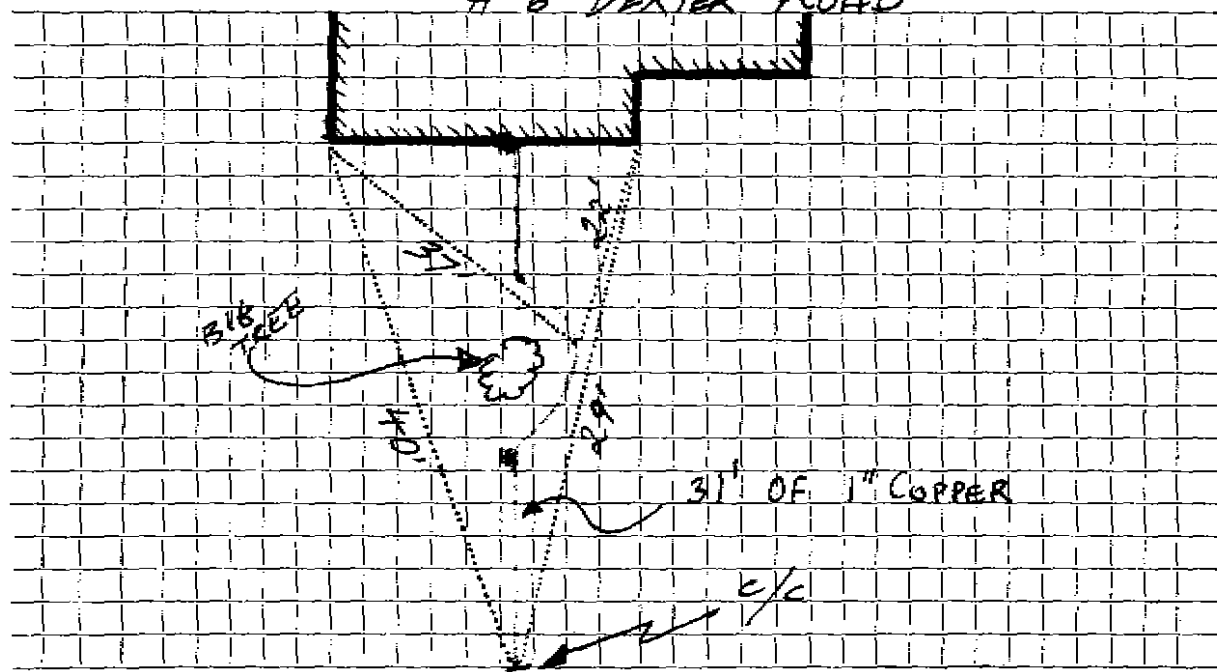

Connection made in DEXTER ROAD ~~Street~~ Work completed .....

Remarks: .....