

Name Leeland Construction Company  
 Address 61 Dexter Road  
 Lexington

Service No. 138

# 1850

Location 61 Dexter Road

Kind of Pipe

Size

Size of Main

~~Repair & Renewal~~ - New Service

Com. 9-5-50

Location

Date	Material	Amount	Total	Date	Amount
July 7 '50	Labor	1 30		June 21 '50	20 00
	10% Overhead	13	1 43	<i>Deposited</i>	<u>2 11</u>
	34' - 3/4" Copper Tubing @ 23¢	7 82			13 29
	1 - 3/4" C x 1/2" L.W.H. S&W	3 29			
	1 hr. Trucking		75	No Charge	
			13 29	July 7 '50 Labor	1 30
				13' - 3/4" Copper Tubing @ 23¢	2 99
				1 - 3/4" C. Corp-cock	3 15
				1 - 3/4" C x 3/4" C Curb-cock	3 85
				1 Box & Rod	3 35
				1 - 1/2" Offset Tail Piece	38
				1 - 1/2" Straight Tail Piece	38
				1 hr. Trucking	75
	Labor				<u>16 15</u>

DATE \_\_\_\_\_

TOWN OF LEXINGTON - BOARD OF PUBLIC WORKS  
**WATER DIVISION**

The undersigned applies for a supply of water at No..... St. and hereby agrees to comply with the rules and regulations as now, or at any future time, established by the Board of Selectmen.

Am't of Estimate \$.....

Owner .....


Am't Paid \$.....

Address .....

Builder .....

.....

Sketch of Service Here

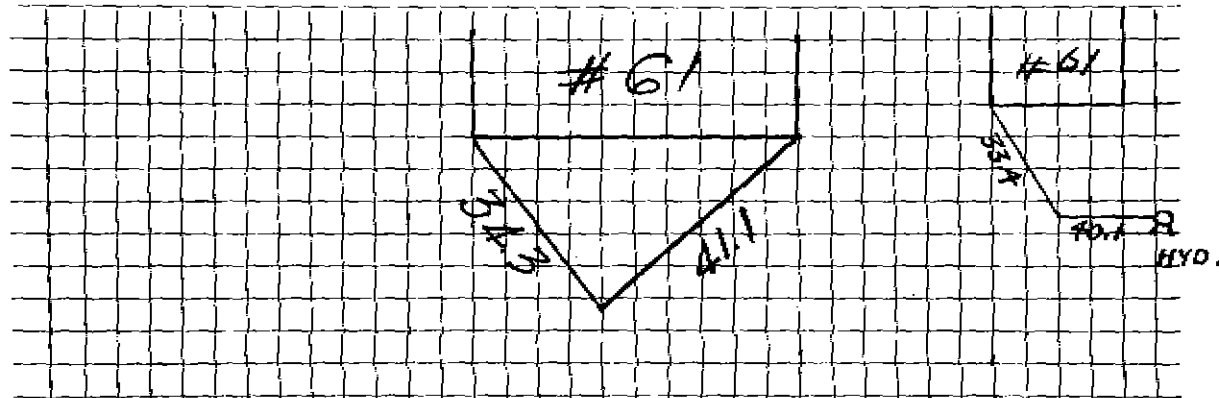

Connection made in ..... Street.

Work completed .....19

Remarks: