

Name Monson MacPhee

Service No.

3968
#5130

Address 62 Dexter Road

Location 62 Dexter Road

Kind of Pipe

Size

Size of Main

~~REPAIRS~~—New Service

Location

Date	Material	Amount	Total	Date	Location	Amount
Sept. 25, '47	Labor	1 10	1 10	Sept 25 '47	Deposited	30 00
	10% Overhead		11	Dec 4 '47	Returned	13 43
	39' - 3/4" Copper Tubing @.26	10 14	10 14		Non-Charge	16 57
	1 - 3/4" C x 1/2" I.W.H. S & W	3 15	3 15	Sept. 25, '47	Labor	17 57
	1 - 3/4" C x 3/4" C U 3 pt.	1 32	1 32		27' - 3/4" Copper Tubing @.26	7 02
	Trucking 1 hr. @.75		75		1 - 3/4" Corp-cock	3 00
			16 57		1 - 3/4" C x 3/4" C Curb-cock	3 68
					1 - Box & Rod	4 26
					1 - 1/8" Offset Tail Piece	30
					1 - 1/2" Straight Tail Piece	30
					Compressor 1 hr. @1.75	1 75
					Trucking 1 hr. @.75	75
	Labor					38 63

DATE _____

TOWN OF LEXINGTON - BOARD OF PUBLIC WORKS

WATER DIVISION

The undersigned applies for a supply of water at No..... St. and hereby agrees to comply with the rules and regulations as now, or at any future time, established by the Board of Selectmen.

Am't of Estimate \$.....

Owner


Am't Paid \$.....

Address

Builder

.....

Sketch of Service Here

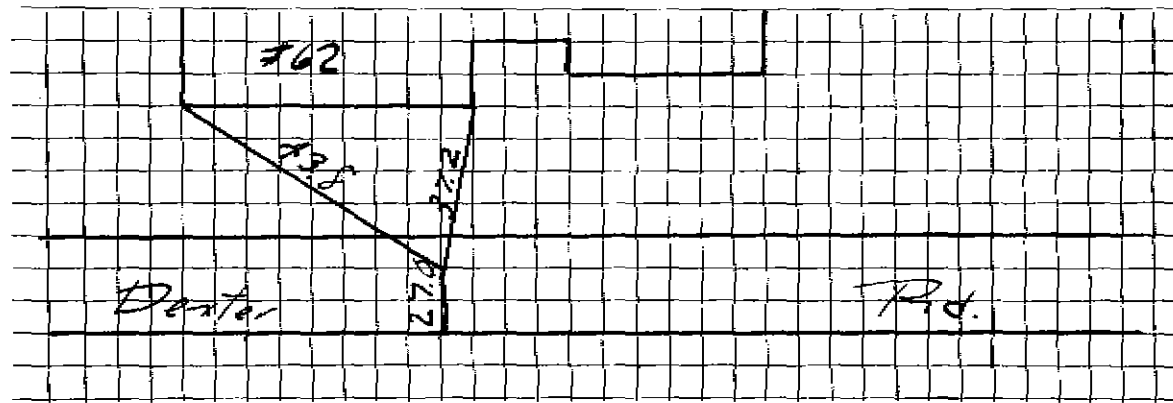

Connection made in Street.

Work completed19

Remarks: