

Name A. R. Miller

Service No. 158

Address 68 Dexter Road

Lexington, Mass.

Location 68 Dexter Road

Kind of Pipe

Size

Size of Main

~~Repair - Renewal~~ New Service

Com. 9-5-50

Location

Date	Material	Amount	Total	Date	Amount
Jul. 18, '50	Labor	1 30	1 30	July 18, '50	25 00
	10% Overhead		13		
	56' - 3/4" Copper Tubing @.23	12 88			17 75
	1 - 3/4" C x 1/2" I.W.H. S&W	3 29		Jul. 18, '50	1 30
	1 - 3/4" C x 3/4" C Union (3pts)	1 39		36' - 3/4" Copper Tubing @.23	8 28
	Trucking 1 hr. @.75		75	1 - 3/4" C Corp-cock	3 15
			19 74	1 - 3/4" C x 3/4" C Curb-cock	3 85
				1 - Box & Rod	3 35
				1 - 1/2" Straight Tail Piece	38
				1 - 3/8" Offset Tail Piece	38
				Trucking 1 hr. @.75	75
					21 44
	Labor				

Repaired

No Charge

Hadley Press, Inc., Lexington

DATE _____

TOWN OF LEXINGTON—BOARD OF PUBLIC WORKS

WATER DIVISION

The undersigned applies for a supply of water at No. _____ St. and hereby agrees to comply with the rules and regulations as now, or at any future time, established by the Board of Selectmen.

Am't. of Estimate \$ _____


Owner _____

Am't. Paid \$ _____

Address _____

Builder _____

Sketch of Service Here

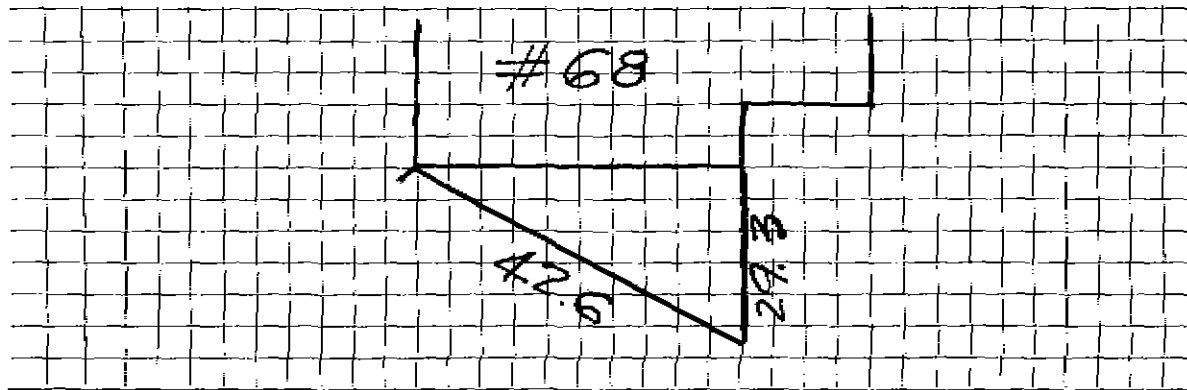

Connection made in _____ Street. Work completed _____ 19

Remarks: