

## WATER SERVICE RECORD

Name Peter Franks

Service No. 34

Address 7 Dexter Road

Location

~~Repair—Renewal—New Service~~ WO #4670


Date	Material	Amount	Total	Date	Amount
7/9/76	labor	44.42		7-1-76	Deposit 200.00
	10% OH	4.44	48.86	8-16-76	Refund 142.75
37'	6" 3/4" Copper @ .65		24.44		107.25
1	3/4" Wheel handle stop and waste		14.53		OUTSIDE
1/2	yard loam @ 4.50		2.25	7/9/76	labor 66.63
3	lbs. grasseed @ .39		1.17	7/12/76	labor 73.09
2	hrs. shovel @ 6.50		13.00		10' 4" 3/4 Copper @ .65 6.76
1	hr. trucking		3.00		1 3/4" Copper Corp. 5.12
			107.25		2 hr. shovel @ 6.50 13.00
					4 hr. trucking @ 3.00 12.00
					190.30

DATE \_\_\_\_\_

TOWN OF LEXINGTON — BOARD OF PUBLIC WORKS

**WATER DIVISION**

Sketch of Service Here

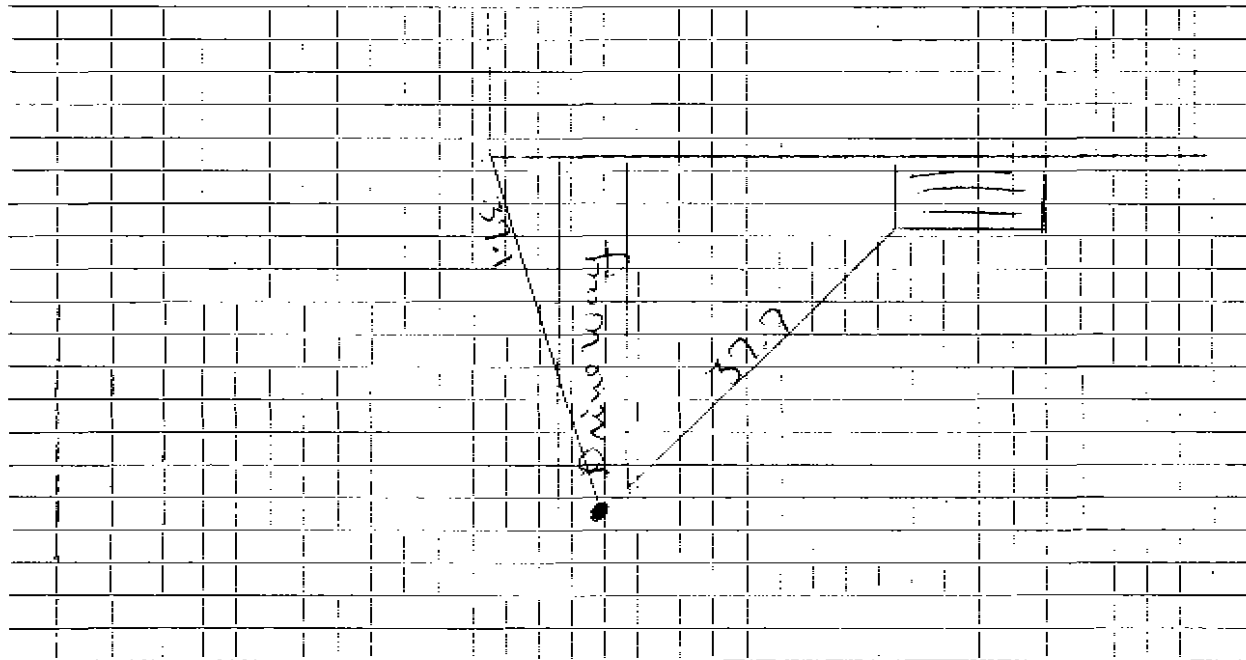

Connection made in ..... Street. Work completed .....

Remarks: .....  
.....  
.....