

WATER SERVICE RECORD

Name Benjamin Franklin Homes

Service No. 52

Address 10 Diamond Road

3382

Location Lot 9 Stg 7+89

Repair Renewal New Service


Comm 10-28-63

Date	Material	Amount	Total	Date		Amount
9-24-62 ✓	Labor	2.13		8-14-63	Deposit	25.00
	10% O.H.	.21	2.34	10-28-63 ✗	ReFund	10.39
	14' 3/4" Copper tubing @.42		5.88			64.61
	BILL WHEN CONNECTED		8.22		NON CHARGE	
7-3-63	Labor	4.62		9-24-62	Labor	2.13
	10% O.H.	.46	5.08		6' 3/4" Copper tubing @.42	2.52
	96' 3/4" Copper Tubing @.42		40.32		1 3/4" C Corp Cock	4.91
	1 3/4" CX 1/2 I.W.H. Stop & Waste		6.17		1 3/4" C Curb Cock	6.28
	2 3/4" C3 Part Union @2.41		4.82		1 Box & Rod	4.90
			64.61			20.74
				7-3-63	1 1/8 Straight Tailpiece	.50
					1 1/8 Offset Tailpiece	.50
						21.74
✗ Applied to OH OH 56						

DATE _____

TOWN OF LEXINGTON — BOARD OF PUBLIC WORKS

WATER DIVISION

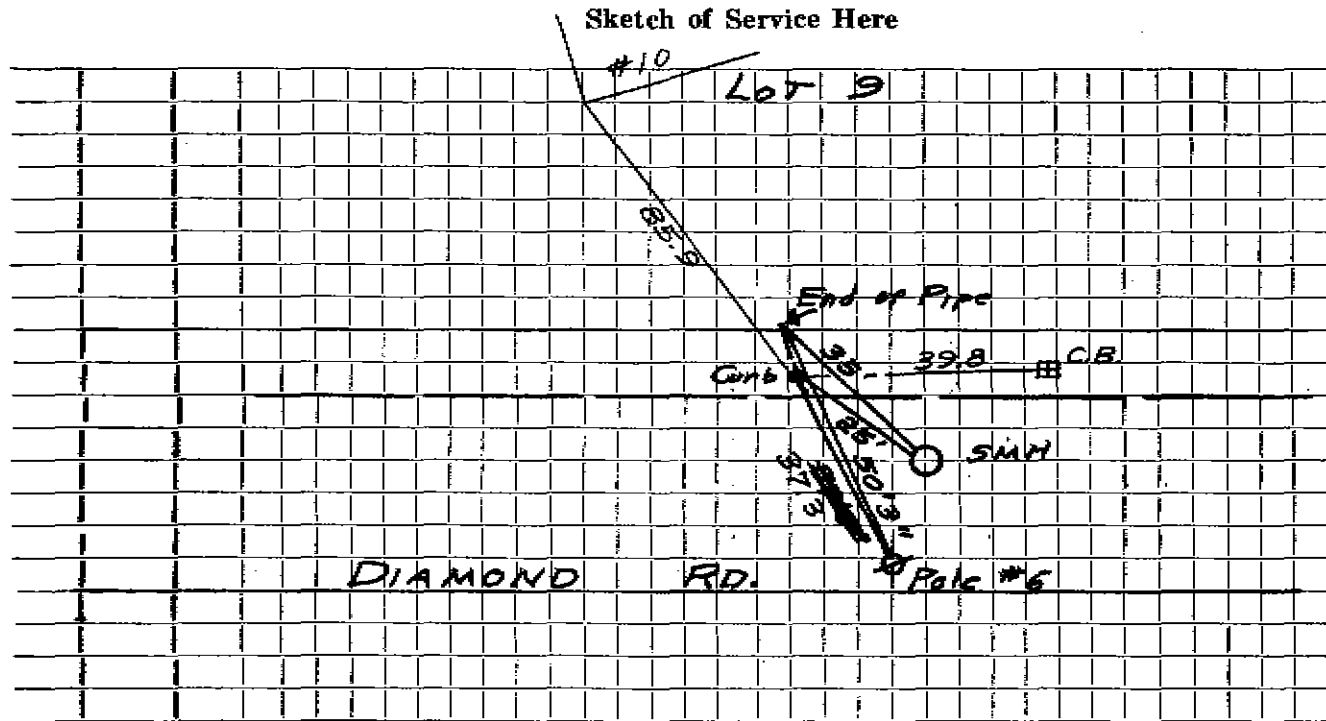

Connection made in Street. Work completed

Remarks:
.....
.....