

WATER SERVICE RECORD

Name Benjamin Franklin Homes, Inc.

Service No. 105

Address 11 Diamond Road.

FF 6922

Location Lot 5 Sta. 9+17

~~Repair or Reserial~~ New Service W.O. #7534

Comm 10-29-62


Date	Material	Amount	Total	Date		Amount
9-7-62	Labor	2.13		8-13-62	Deposit	35.00
	10% O.H.	.21	2.34	11-5-62		17.92
100'	3/4" Copper tubing @.42		42.00			52.92
1	3/4" CX 1/2 I.W.H. Stop & Waste		6.17			
1	3/4" C3 Part Union		2.41		NON CHARGE	
			52.92	9-7-62	Labor	2.13
				26'	3/4" Copper tubing @.42	10.92
				1	3/4" C Corp Cock	4.91
				1	3/4" C Curb Cock	6.28
				1	Box & Rod	4.91
				1	1/2 Straight Tailpiece	.50
				1	1/2 Offset Tailpiece	.50
						30.14

DATE \_\_\_\_\_

**TOWN OF LEXINGTON — BOARD OF PUBLIC WORKS**

**WATER DIVISION**

Sketch of Service Here

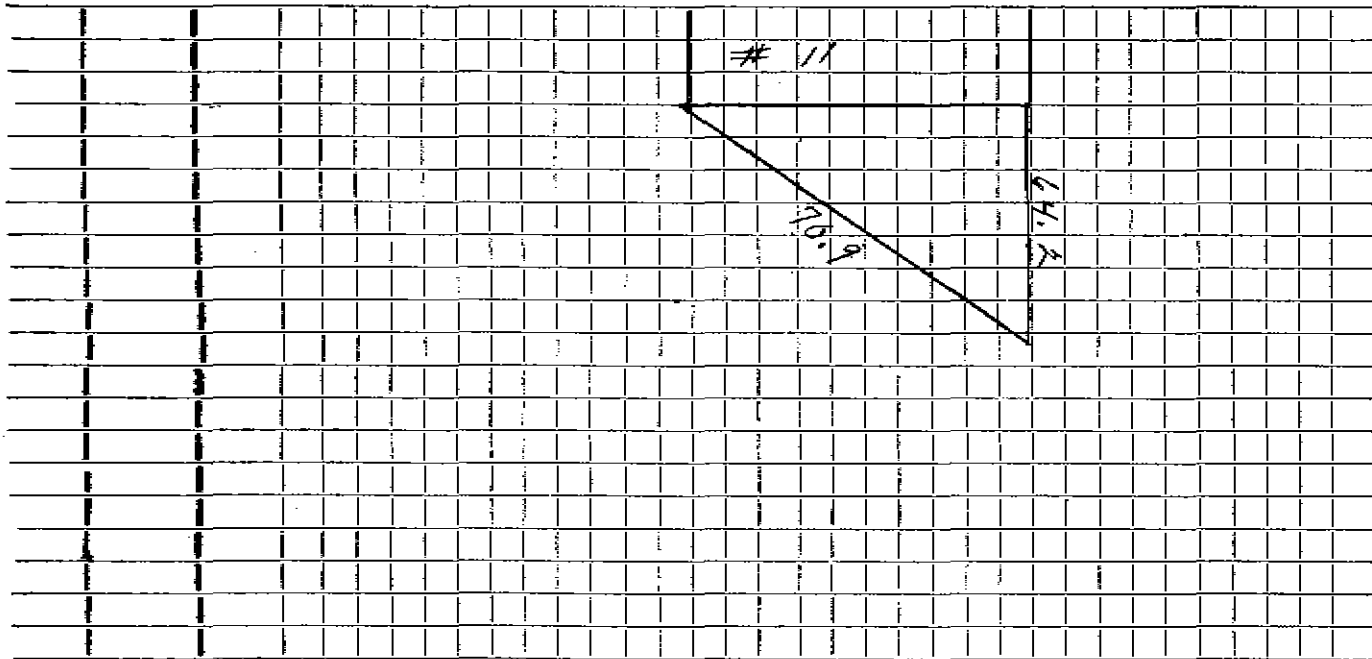

Connection made in ..... Street. Work completed .....

Remarks: .....  
.....  
.....