

## WATER SERVICE RECORD

#5127

Name Ben Franklin Homes

Service No. 8

Address 12 Diamond Road

Location Lot #8 Sta. 9+41

~~Renewal~~ New Service *W.C. # 7813**Comm 8-26-63*


Date	Material	Amount	Total	Date	Amount	
9-25-62	Labor	2.13		4-3-63	Deposit	50.00
	10% O.H.	.21	2.34	8-26-63	Paid by SHC# 216	5.02
	14' 3/4" Copper tubing @.42		5.88			55.02
	BILL WHEN CONNECTED		8.22		NON CHARGE	
4-16-63	Labor	2.77		9-25-62	Labor	2.13
	10% O.H.	.28	3.05	9'	3/4" Copper tubing @.42	3.78
	78' 3/4" Copper tubing @.42		32.76	1	3/4" C Corp Cock	4.91
	2 3/4" C 3 part unions @2.41		4.82	1	3/4" C Curb Cock	6.28
	1 3/4" x 1/2 I.W.H. Stop & Waste		6.17	1	Box & Rod	4.90
			55.02			22.00

DATE \_\_\_\_\_

TOWN OF LEXINGTON — BOARD OF PUBLIC WORKS

WATER DIVISION

Sketch of Service Here

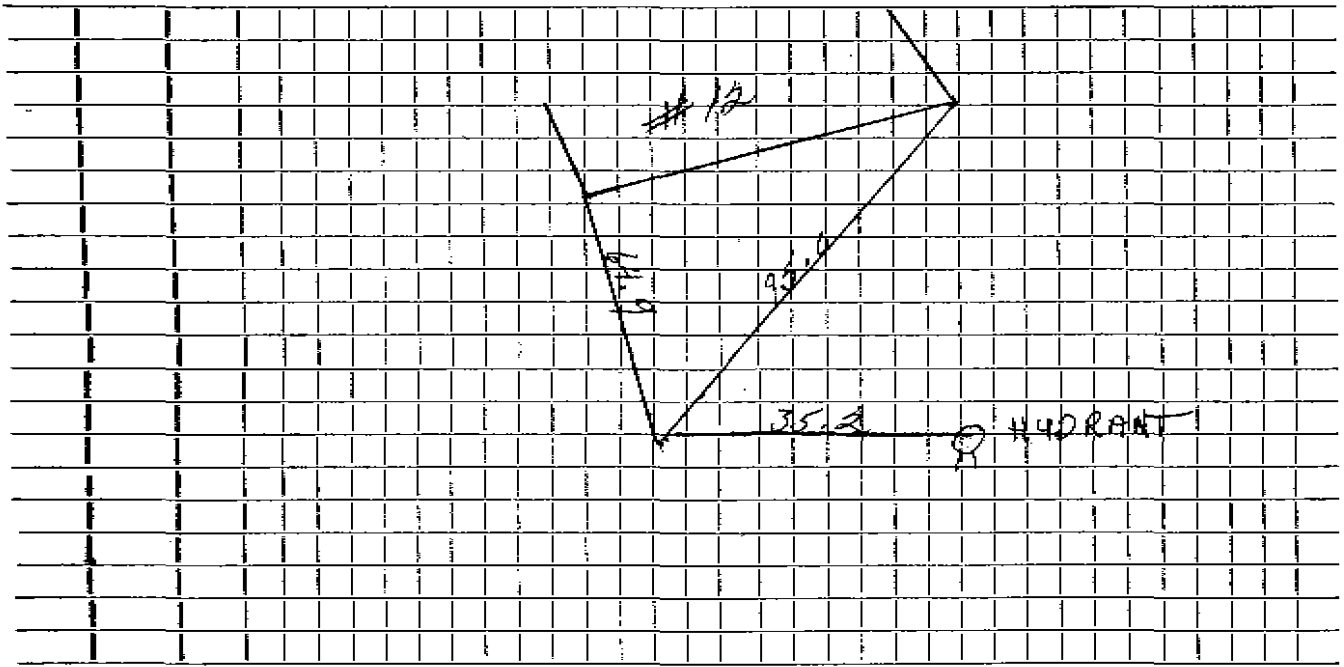

Connection made in \_\_\_\_\_ Street. Work completed ..... 7.16.63 .....

Remarks: ..... Service installed curb to house by builder .....