

## WATER SERVICE RECORD

Name Benjamin Franklin Homes, Inc.

Service No. 106

Address 15 Diamond Road

# 7534

Location Lot 6 Sta. 10+69

~~Repair - Renewal~~ New Service W.O. #7535

Comm 10-29-62


Date	Material	Amount	Total	Date	Amount
9-6-62	Labor	2.13			
	10% O.H.	.21	2.34	8-13-62	Deposit
	93' 3/4" Copper tubing @42		39.06	11-5-62	
	1 3/4" CX 1/2 I/W.H. Stop & Waste		6.17		
	1 3/4" C3 Part Union		2.41		
			49.98		NON CHARGE
				9-6-62	Labor
					23' 3/4" Copper tubing@
					1 3/4" C Corp Cock
					1 3/4" C Curb Cock
					1 Box & Rod
					1 1/2 Offset Tailpiece
					1 1/2 Straight Tailpiece
					28.77

DATE \_\_\_\_\_

**TOWN OF LEXINGTON — BOARD OF PUBLIC WORKS**

**WATER DIVISION**

Sketch of Service Here

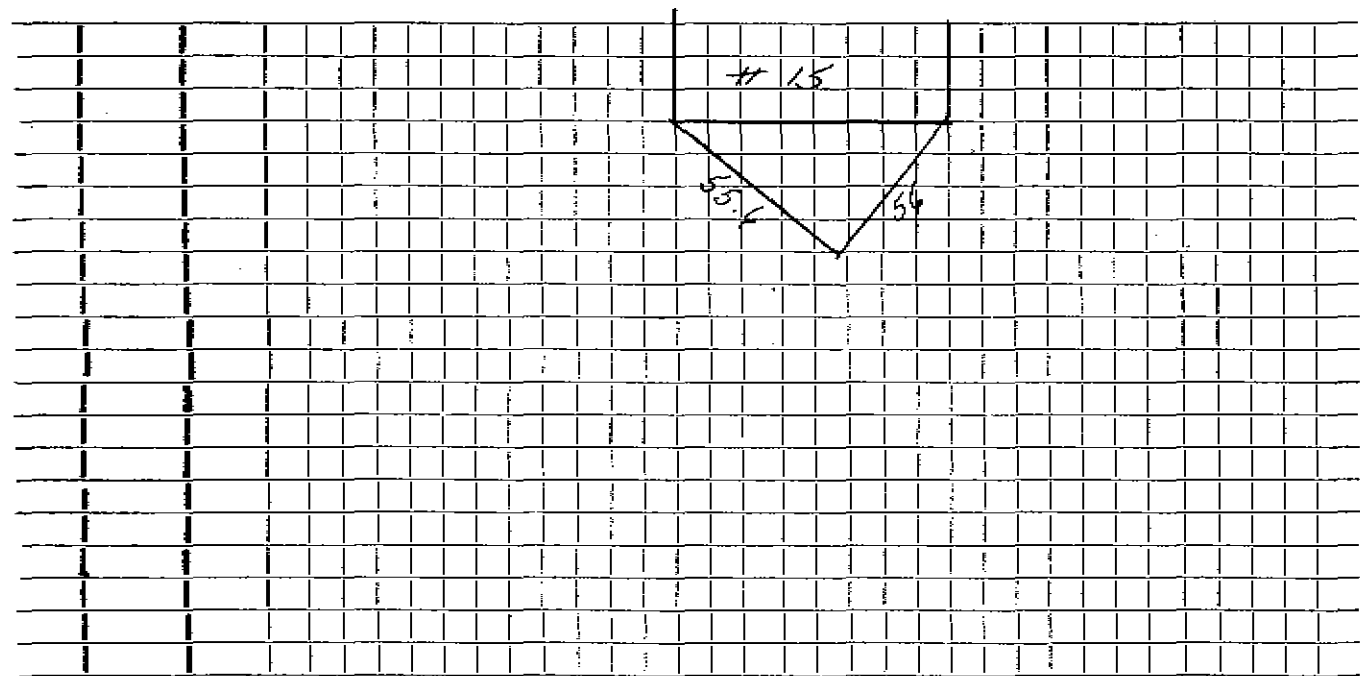

Connection made in ..... Street. Work completed .....

Remarks: .....  
.....  
.....