

WATER SERVICE RECORD

Name Benjamin Franklin Homes, Inc.

Service No. 108

Address 16 Diamond Road

942

Location Lot 7A Sta. 10+62

~~Repair -~~ New Service W.O. # ~~203~~ 7537

Comm 10-29-62


Date	Material	Amount	Total	Date		Amount
9-6-62	Labor	25.76		8-13-62	Deposit	40.00
	10% O.H.	2.58	28.34	10-29-62	Paid by SHC # 102	6.07
10-4	3/4" Copper tubing @ .42		43.68	11-5-62		3.75
1	3/4" CX 1/2 I/W.H. Stop & Waste		6.17			83.60
1	3/4" C3 Part Union		2.41		NON CHARGE	
1	Hr. Trucking @ 3.00		3.00	9-6-62	Labor	2.24
			83.60	9'	3/4" Copper tubing @ .42	3.78
				1	3/4" C Corp Cock	4.91
				1	3/4" C Curb Cock	6.28
				1	Box & Rod	4.09
				1	1/2 Straight Tail piece	.50
				1	1/2 Offset Tail piece	.50
						22.30

DATE _____

TOWN OF LEXINGTON — BOARD OF PUBLIC WORKS

WATER DIVISION

Sketch of Service Here

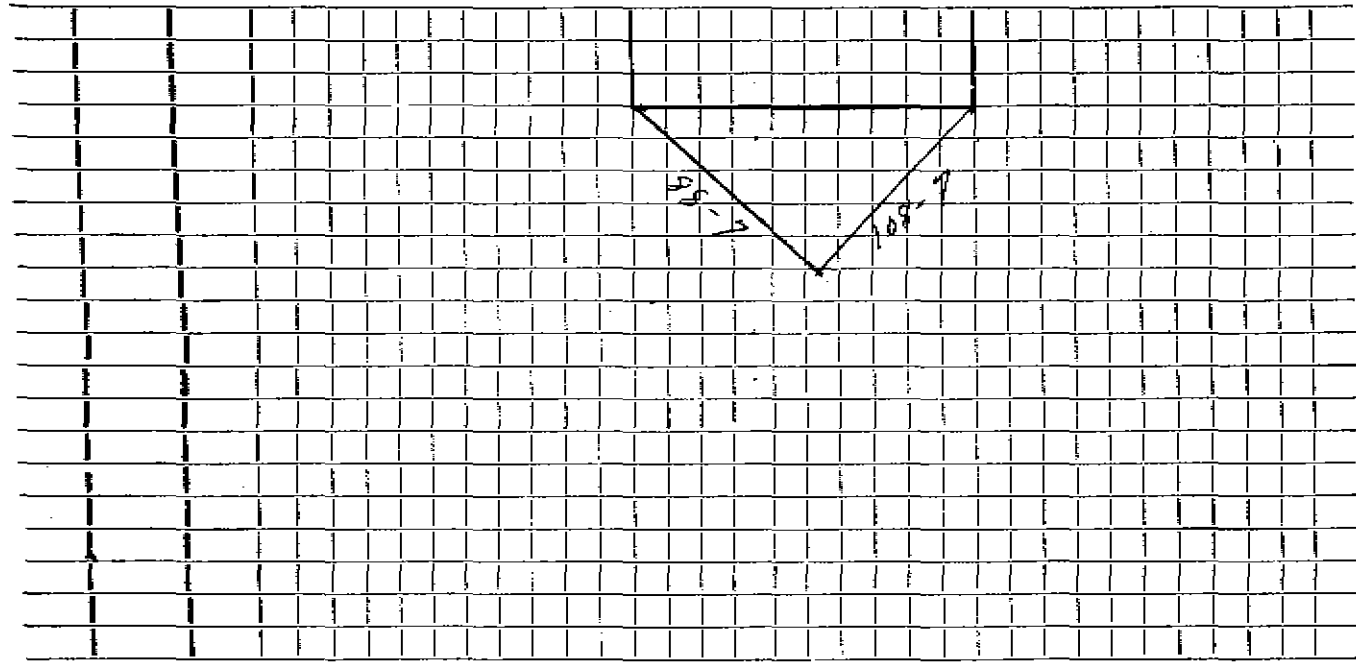

Connection made in Street. Work completed

Remarks:
.....
.....