

WATER SERVICE RECORD

Name John L. Tagen

Service No. 133

Address 17 Diamond Road

#7191

Location

~~Repair~~ ~~Renewal~~ - New Service W.O. #7619

Comm 10-29-62


Date	Material	Amount	Total	Date		Amount
9-8-62	Labor	2.13		9-20-62	Deposit	50.00
	10% O.H.	.21	2.34	12-21-63		17.12
115	3/4" Copper tubing @42		48.30			67.12
1	3/4" CX 1/2 I.W.H. Stop & Waste		6.17			
1	3/4" C3 Part Union		2.41		NON CHARGE	
1	Hr. Trucking @3.00		3.00	9-8-62	Labor	2.13
1	Box & Rod		4.90	24	3/4" Copper tubing @42	10.08
			67.12	1	3/4" C Corp Cock	4.91
				1	3/4" C Curb Cock	6.28
				1	Box & Rod	4.90
				1	1/2" Straight Tailpiece	.50
				1	1/2" Offset Tailpiece	.50
						29.30

Bill 500 12/12

DATE \_\_\_\_\_

**TOWN OF LEXINGTON — BOARD OF PUBLIC WORKS**  
**WATER DIVISION**

Sketch of Service Here

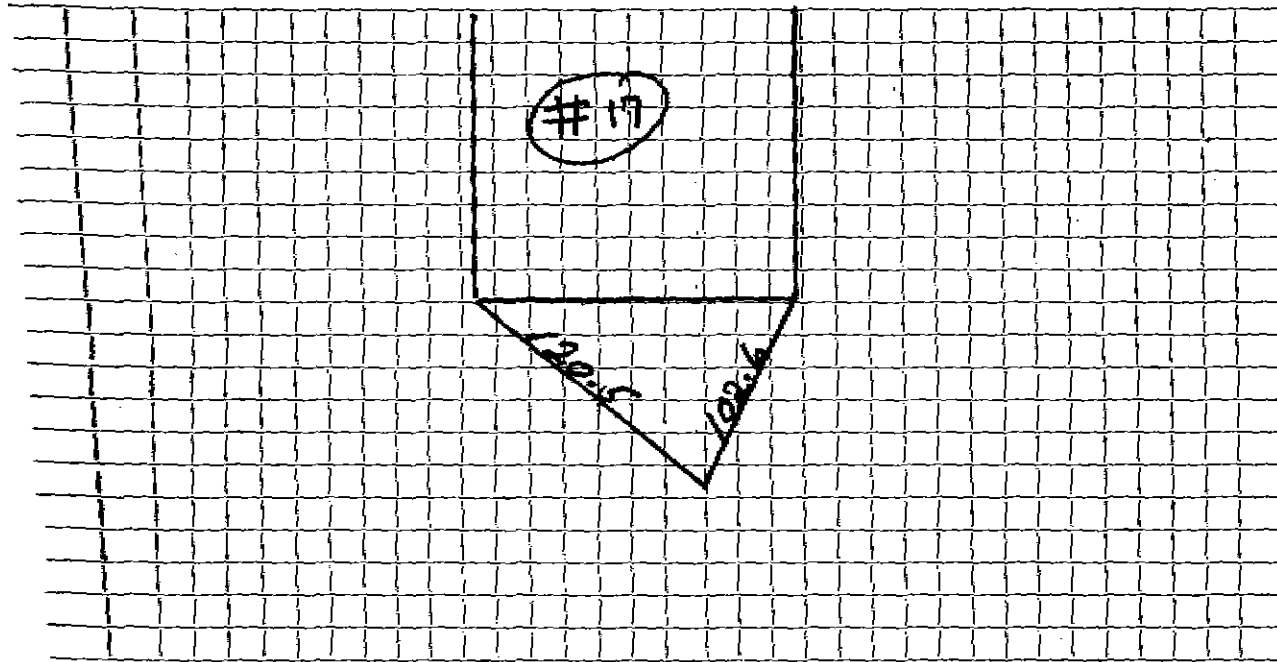

Connection made in ..... Street. Work completed .....

Remarks: .....  
.....  
.....