

WATER SERVICE RECORD

Name Benjamin Franklin Homes, Inc.

Service No. 107

Address 18 Diamond Road

2796

Location

~~Repair Record~~ - New Service W.O. #7536


Comm 10-29-62

Date	Material	Amount	Total	Date	Material	Amount
9-14-62	Labor	2.13		8-13-62	Deposit	35.00
	10% O.H.	.21	2.34	8-28-62	Red by W.H.C.# 127	8.00
88'	3/4" Copper tubing @42		36.96	11-5-62		<u>4.88</u>
1	3/4" CX 1/2 I/W.H. Stop & Waste		6.17			47.88
1	3/4" C3 Part Union		<u>2.41</u>		NON CHARGE?	
			47.88	9-14-62	Labor	2.13
					19' 3/4" Copper tubing @42	7.98
					1 3/4" C Corp Cock	4.91
					1 3/4" C Curb Cock	6.28
					1 Box & Rod	4.90
					1 1/2 Straight Tailpiece	.50
					1 1/2 Offset Tailpiece	.50
						<u>27.20</u>
					Bill sent	4.88

DATE _____

TOWN OF LEXINGTON — BOARD OF PUBLIC WORKS
WATER DIVISION

Sketch of Service Here

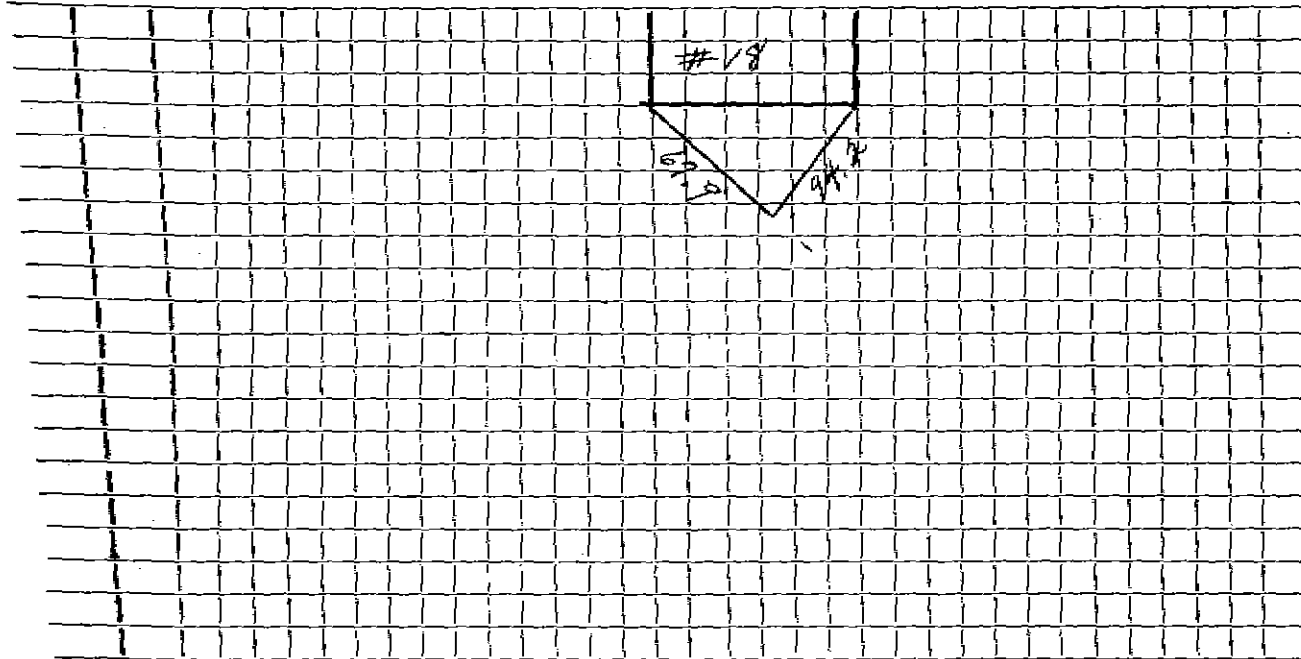

Connection made in Street. Work completed

Remarks:

.....
.....