

WATER SERVICE RECORD

Name Ben Franklin Homes

4108 + 4109

Service No.

7

Address 3 Diamond Road

Location Lot #1 Sta. 3+26

~~REPAIRS~~ - New Service

WO # 7812

Comm 8-26-63


Date	Material	Amount	Total	Date		Amount
9-18-62	Labor	2.13		4-3-63	Deposit	50.00
	10% O.H.	.21	2.34	8-26-63	Paid by S.H.C. #	8.38
	12' 3/4" Copper tubing @.42		5.04			58.38
	BILL WHEN CONNECTED		7.38		NON CHARGE	
4-9-63	88' 3/4" Copper tubing @.42		36.96	9-18-62	Labor	2.13
	2 3/4" C 3 part unions @2.41		4.82		30' 3/4" Copper tubing	12.60
	1 3/4" x 1/2" I.W.H. Stop & Waste		6.17		1 3/4" C Corp. Cock	4.91
	Labor	2.77			1 3/4" C Curb Cock	6.28
	10% O.H.	.28	3.05		1 Box & Rod	4.90
			58.38			30.82
					1 1/2" Straight tailpiece	.50
					1 1/2" Offset tailpiece	.50
						31.82

DATE _____

TOWN OF LEXINGTON — BOARD OF PUBLIC WORKS

WATER DIVISION

Sketch of Service Here

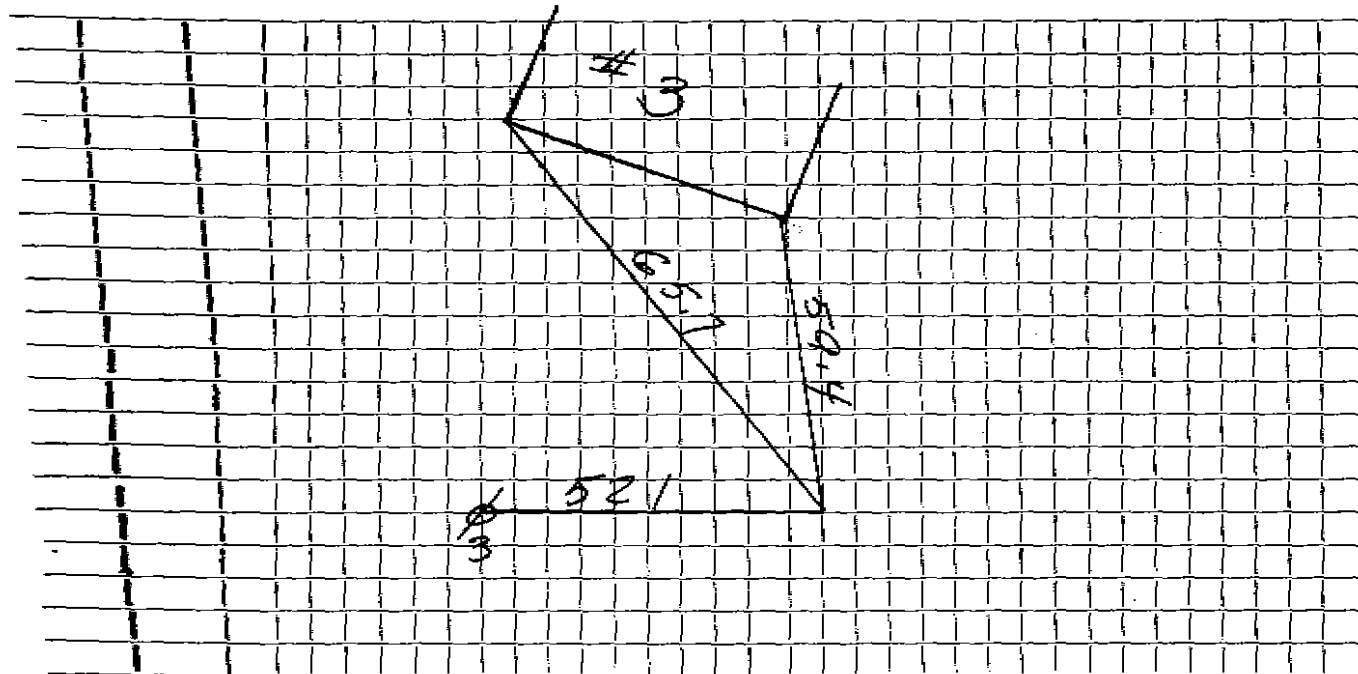

Connection made in _____ Street. Work completed 4/9/63

Remarks: S. E. RYICE INSTALLED CURB TO HOUSE

By BUILDER