

WATER SERVICE RECORD

6814

Name Benjamin Franklin Homes

Service No. 43

Address 7 Diamond Road

5351

Location Lot #3 9th 6725

~~Resistor Renewal~~ - New Service

Comm 10-28-63

Date	Material	Amount	Total	Date	Material	Amount
9-20-62	Labor	2.13		6-14-63	Deposit	50.00
	10% O.H.	.21	2.34	11-8-63	Paid	19.24
	15' 3/4" Copper tubing @.42		6.30			69.24
	BILL WHEN CONNECTED		8.64		NON CHARGE	
6-6-63	Labor	4.73		9-20-62	Labor	2.13
	10% O.H.	.47	5.20	38' 3/4" Copper tubing @.42		15.96
	100' 3/4" Copper tubing @.42		42.00	1 3/4" C Corp Cock		4.91
	1 3/4" C x 1/2 I.W.H. Stop & Waste		6.17	1 3/4" C Curb Cock		6.28
	3 3/4" C 3 part unions @2.41		7.23	1 Box & Rod		4.90
			69.24			34.18
				1 1/2 Straight tailpiece		50
				1 1/2 Offset tailpiece		50
						34.18


Bill sent 1934

DATE _____

TOWN OF LEXINGTON — BOARD OF PUBLIC WORKS

WATER DIVISION

Sketch of Service Here

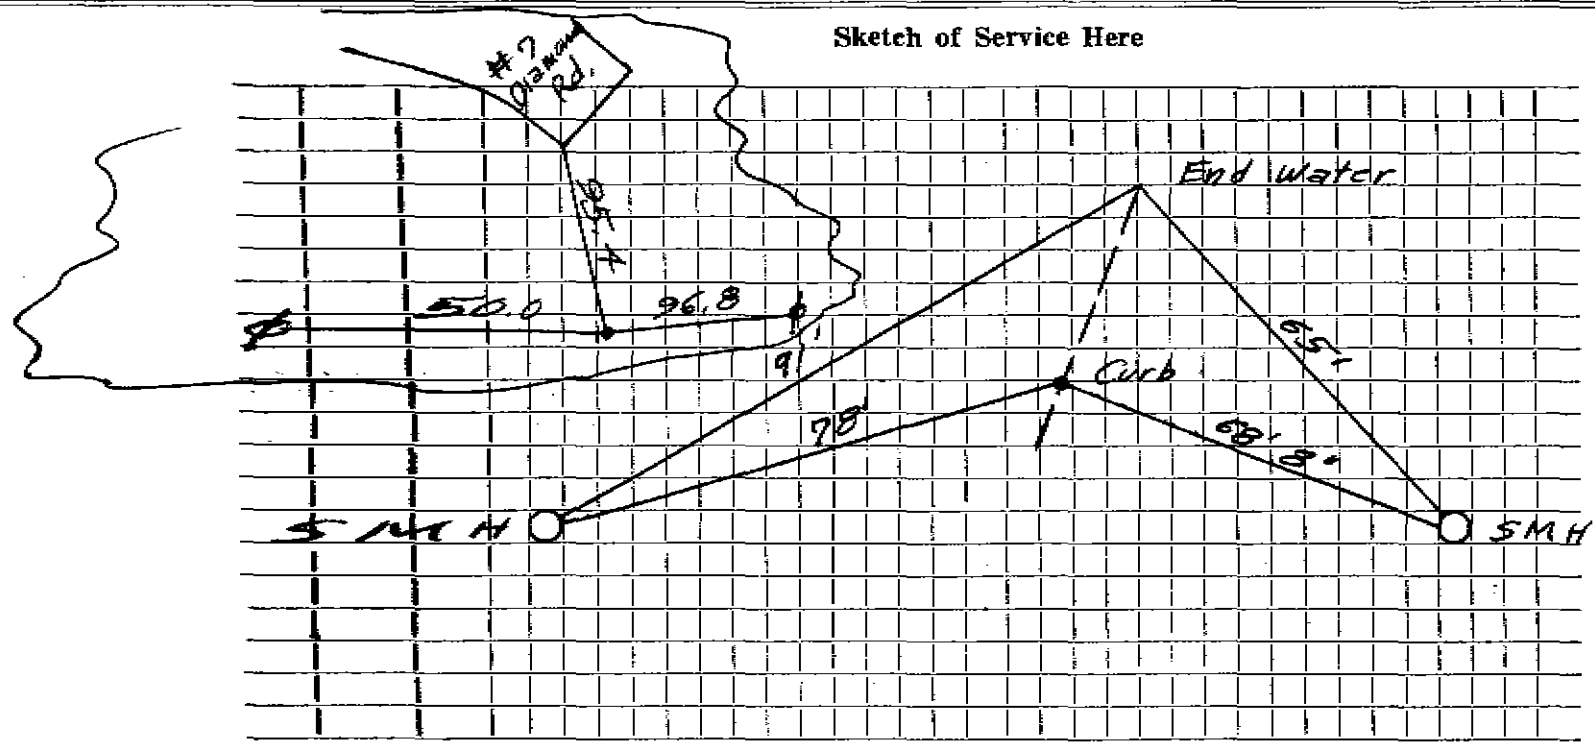

Connection made in Street. Work completed

Remarks:
.
.