

WATER SERVICE RECORD

Name Leeland Construction Co., Inc.

Service No. 134

Address 11 Diana Lane

3301

Location

~~Repair~~ ~~Reconnect~~ — New Service

Comm 7-18-55


Date	Material	Amount	Total	Date	Amount
6/2/55	Labor	1 85		5-17-55	Deposited 50 00
	10% overhead	19	2 04	7-18-55	Refunded (15 64)
	70% - 3/4" copper tubing @ .3603	36 93	23 85		NON CHARGE 34 36
	1 - 3/4" C x 1/2 I.W.H. stop & waste		4 00	6/2/55	Labor 3 90
	1 - 3/4" C. union		1 72		14' - 3/4" copper tubing @ .3603 5 17
	1 hr. trucking		75		1 - 3/4" C. comp-cock 1 33
			34 36		1 - 3/4" C. curb-cock 4 67
	TRENCH DUG BY OWNER:				1 box end rod 3 90
					1 - 2 straight tail pc. 50
					1 - 2 offset tail pc. 50
					1 2/3 hrs. Littlefield shovel @ 7.50
					12 50
					1 hr. trucking 75
					36 22

DATE _____

TOWN OF LEXINGTON — BOARD OF PUBLIC WORKS

WATER DIVISION

Sketch of Service Here

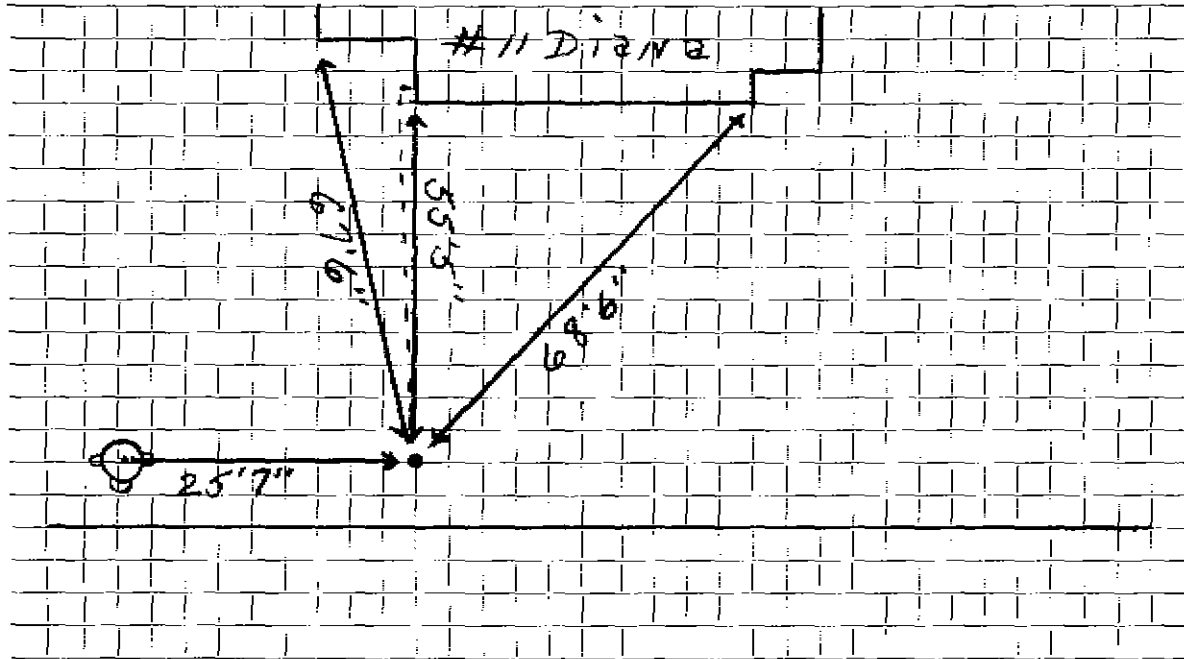

Connection made in Street. Work completed

Remarks:

.....

.....