

WATER SERVICE RECORD

Name Dr. Lawrence K. Pious

Service No. 10

Address 15 Diana Lane

# 10 # 10  
~~# 83012~~


Location

Repair ~~REPAIR~~ - New Service

Date	Material	Amount	Total	Date	Amount
3/16/56	Labor	42 70		2-6-56	Deposit \$ 100 00
	10% overhead	4 27	46 97	8-20-56	Paid 129 3
	118' - 3/4" Copper tubing @ .4850	57.23			NON CHARGE #112 93
	1-3/4 Gx 1/2 I.W.E. Stop & Was te	4 96		3/16/56	Labor 13 87
	1-Union (3 part)	2 27		71' 3/4" Copper tubing @ .4850	34.44
	2 hrs. trucking @ .75	1 50		1 hr. Allis-Chalmers	3 00
			112 93	2 hrs. Town Shovel @ 6.00	12 00
				2 3-part Unions @ 2.27	4 54
				1 - 1/2 Straight tailpiece	50
				1 - 1/2 Offset tailpiece	50
					68 85
				9/16/55	
					18' 3/4 COPPER
					3/4 CORP
					3/4 CURB COCK
					BOX + ROD

**TOWN OF LEXINGTON — BOARD OF PUBLIC WORKS**  
**WATER DIVISION**

Sketch of Service Here

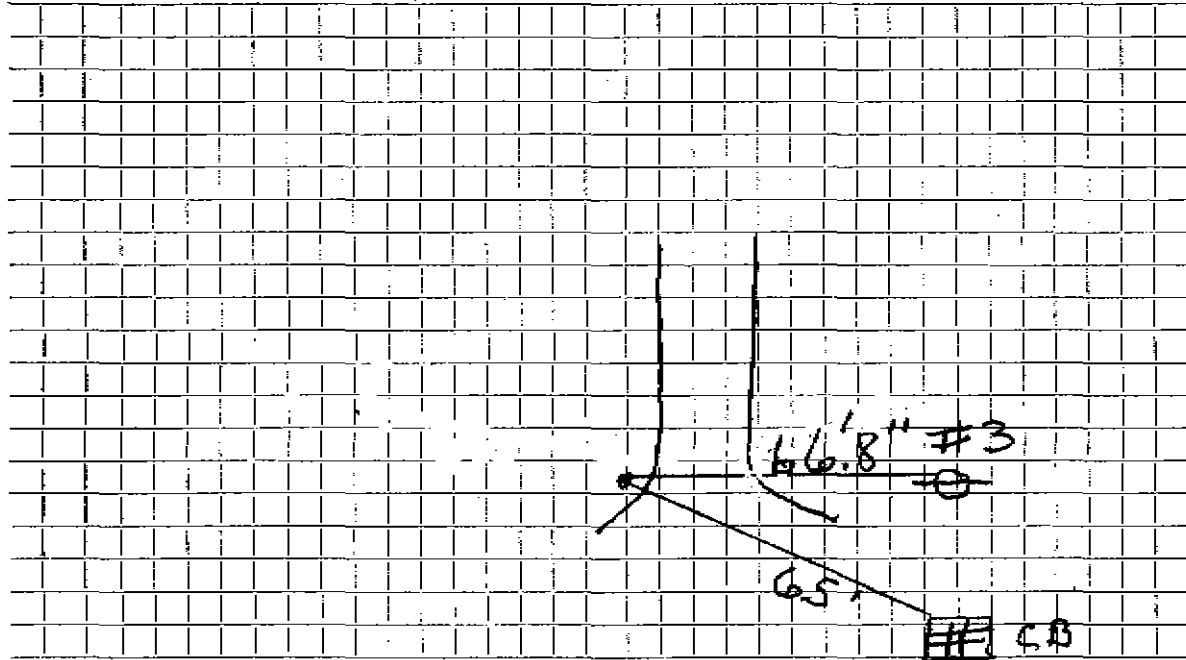

Connection made in ..... Street. Work completed .....

Remarks: .....  
.....  
.....