

WATER SERVICE RECORD

Name

Service No.

Address

17 Diane Lane

Location

~~Repair - Renewal~~ - New ServiceService to curb ~~only~~


Date	Material	Amount	Total	Date	Amount
4/5/56	93 3/4 COPPER				
	2 3/4 UNIONS				
	1 3/4 x 1/2 S & W				
				9/18/55	Non Charge
					Labor
					1 60
					18'-3/4" Copper tubing @.56
					10 08
					1-3/4" C Corp Cock
					4 33
					1-3/4" C Curb Cock
					4 67
					1 Box & Rod
					3 90
					1 hr. trucking @.75
					75
					25 33

DATE _____

TOWN OF LEXINGTON — BOARD OF PUBLIC WORKS

WATER DIVISION

Sketch of Service Here

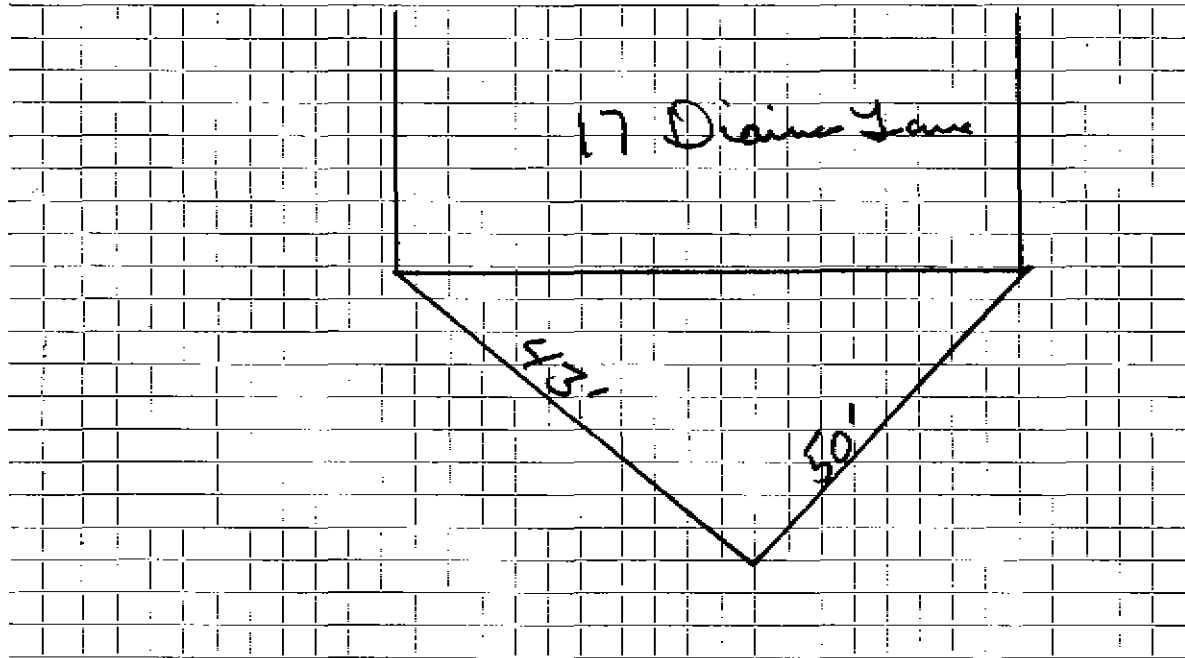

Connection made in Street. Work completed

Remarks:

.....
.....