


TOWN OF LEXINGTON — BOARD OF PUBLIC WORKS
WATER DIVISION

DATE 2/4/2021

Sketch of Service Here

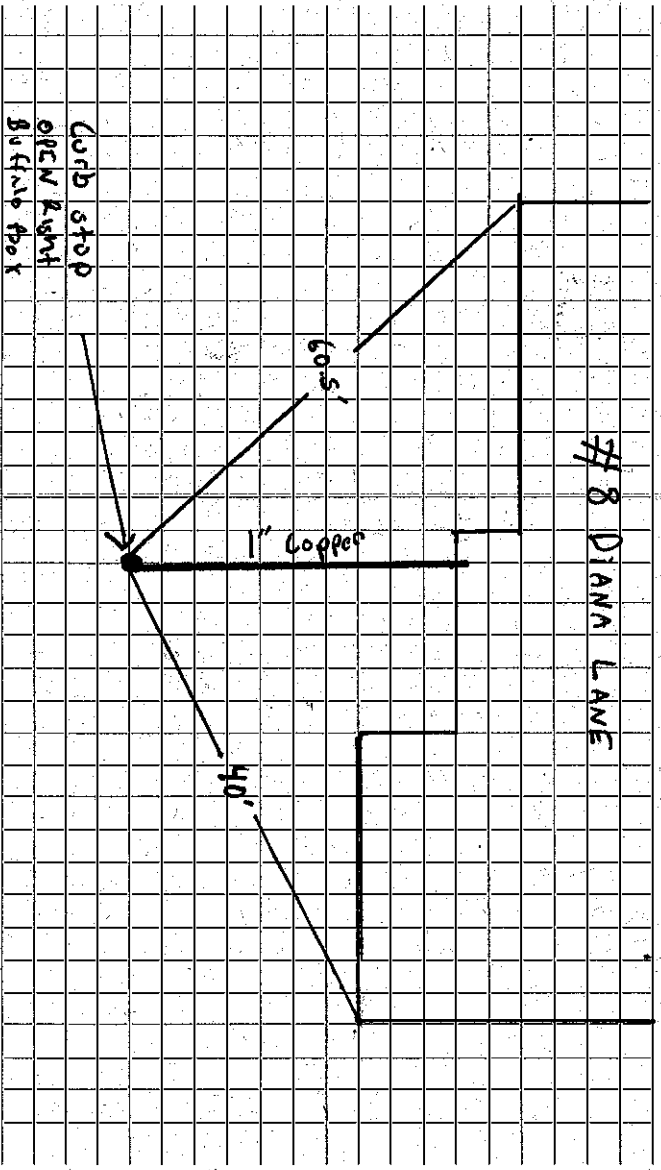

Connection made in..... DIANA Street..... Work completed.....
 Remarks:..... - Observed Depth = 5 FT

WATER SERVICE RECORD

Name Richard Soule

Service No. 176

Address 8 Diana Lane

#17395

Location

~~Repair~~ ~~Renewal~~ New Service

Com. 8-10-53

Date	Material	Amount	Total	Date	Amount
7/23/53	Labor	20 67		6-29-53	200 00
	10% overhead	2 07	22 74	8-10-53	(30 57)
	180' -1" copper tubing@.3997		71 95		169 43
	1 -1"C x 1" I.W.H. stop & waste		5 12	7/23/53	21 00
	3 -1"C x 1"C. unions @2.26		6 78	30' -1" copper tubing@ .3997	11 99
	1 -1" X 3/4" bushing		59	1 - 1" C. corp-cock	5 61
	5 hrs. Littlefield shovel@ 7.50		37 50	1 - 1"C x 1"C. curb-cock	6 80
	1 hr. trucking		75	1 box and rod	3 90
	patching 24 x 3		24 00	1 - 3/4" offset tail piece	50
			169 43	1 - 3/4" straight tail piece	50
				2 hrs. Littlefield shovel @7.50	15 00
				1 hr. trucking	75
					66 05


Deposited
Refunded
NON CHARGE

DATE _____

TOWN OF LEXINGTON — BOARD OF PUBLIC WORKS

WATER DIVISION

Sketch of Service Here

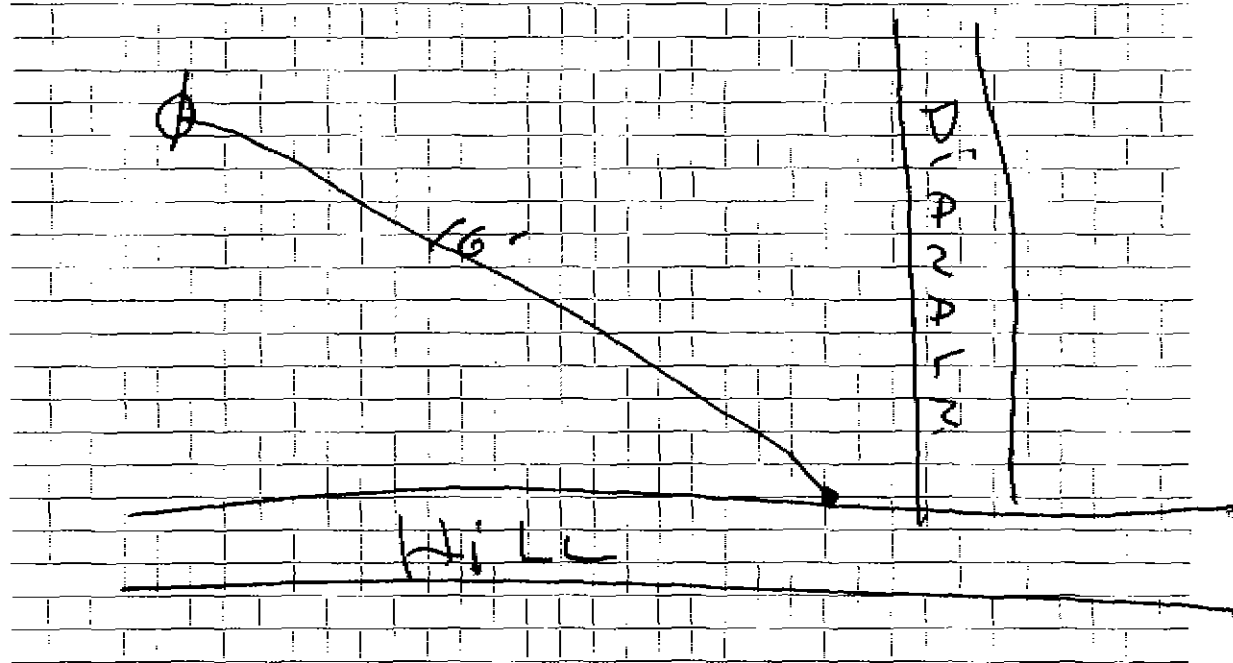

Connection made in Street. Work completed

Remarks:

.....
.....