

#4400

WATER SERVICE RECORD

Name Mark Moore, Jr.

Service No. 57

Address 8 Diehl Road

Location

~~Repair~~ ~~Renewal~~ - New Service

Law. 6-1-54

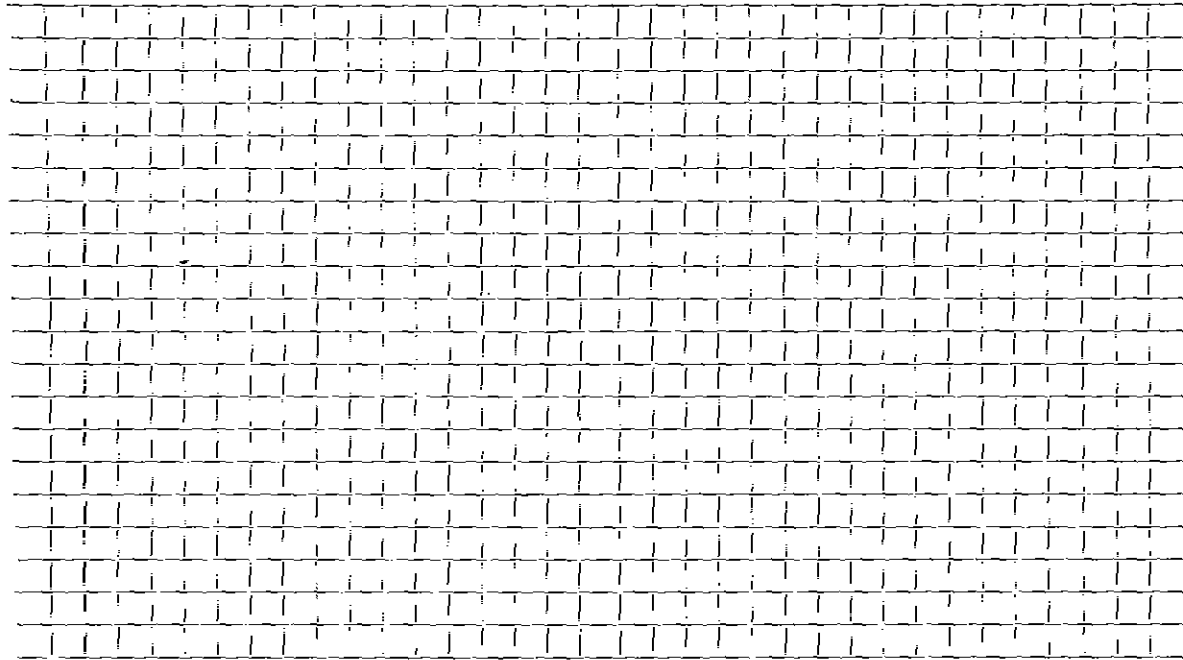
Date	Material	Amount	Total	Date	Amount
5/18/54	Labor	1 85		5-30-54	23 00
	10% Overhead	19	2 04	6-1-54	36
	51' 3/4" Copper tubing @ .35	17 85			NON CHARGE
	1 - 3/4" Cx 1/2" I.W.H. stop & waste	4 00		5/18/54	Labor
	1 hr. trucking	75			1 85
			24 64	40' 3/4" Copper tubing @ .35	14 00
				1 - 3/4" C. Corp-cock	4 33
				1 - 3/4" C.x3/4" C. curb-cock	4 67
				1 Box & Rod	3 90
				1 - 1/2" straight tail piece	50
				1 - 1/2" offset tail piece	50
				1 hr. trucking	75
					<u>30 50</u>

DATE _____

TOWN OF LEXINGTON — BOARD OF PUBLIC WORKS

WATER DIVISION

Sketch of Service Here

A large grid of graph paper, consisting of approximately 20 columns and 25 rows of small squares, intended for sketching service details.

Connection made in Street. Work completed

Remarks:

.....

.....