

Name William E. Viau

Service No.

Address 10 Donald Street

#4524
#7605

Lexington, Mass.

Location 10 Donald Street

Kind of Pipe

Size

Size of Main

Repair ~~Renewal~~ - New Service

Location

| Date | Material | Amount | Total | Date | Location | Amount |
|--------------|---------------------------------|--------|-------|--------------|--|--------|
| Aug. 31, '48 | Labor | 2 45 | 2 45 | Aug 31 '48 | <i>Deposited Refunded Non-Charge</i> | 25 00 |
| | 10% Overhead | | 25 | Oct. 28 '48 | | 4 18 |
| | 44' - 3/4" Copper Tubing @ .255 | 11 22 | 11 22 | | | 20 82 |
| | 1 - 3/4" x 3/8" I.W.H. S & W | 3 15 | 3 15 | Aug. 31, '48 | Labor | 1 15 |
| | Down Shovel 1 hr. @ 3.00 | 3 00 | 3 00 | | 8" - 3/4" Copper Tubing @ .255 | 2 04 |
| | Trucking 1 hr. @ .75 | .75 | 75 | | 1 - 3.4" C Corp-cock | 3 00 |
| | | | 20 82 | | 1 - 3/4" C x 3/4" C Curb-cock | 3 68 |
| | | | | | 1 - Box & Rod | 3 55 |
| | | | | | 1 - 1/2" Straight Tail Piece | 30 |
| | | | | | 1 - 3/8" Offset Tail Piece | 30 |
| | | | | | Trucking 1 hr. @ .75 | 75 |
| | | | | | | 14 77 |
| | Labor | | | | | |

Com. 10/25/48

Hadley Press, Inc., Lexington

DATE _____

TOWN OF LEXINGTON—BOARD OF PUBLIC WORKS

WATER DIVISION

The undersigned applies for a supply of water at No. _____ St. and hereby agrees to comply with the rules and regulations as now, or at any future time, established by the Board of Selectmen.

Am't. of Estimate \$ _____


Owner _____

Am't. Paid \$ _____

Address _____

Builder _____

Sketch of Service Here

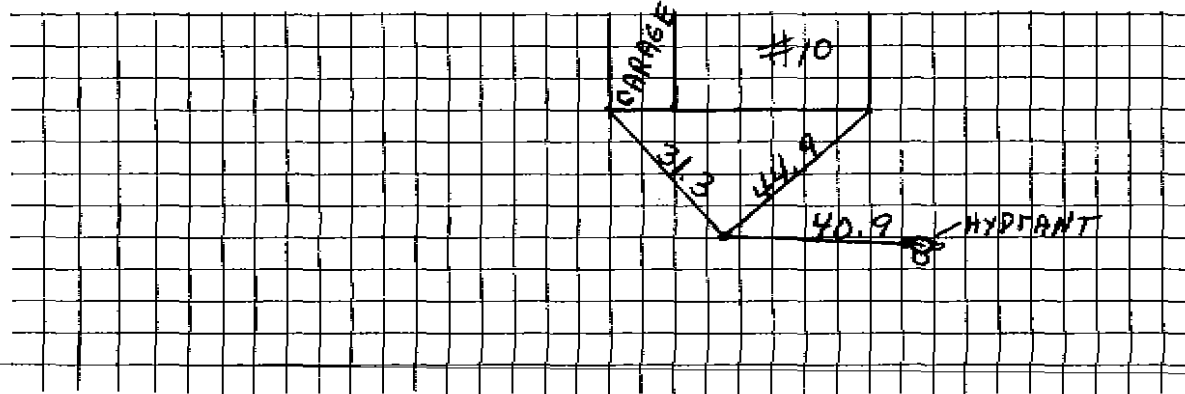

Connection made in _____ Street.

Work completed _____ 19

Remarks: