

Name James P. Sutton

Service No. 255

Address 11 Donald Street

# 4023

Lexington, Mass.

Locatio 11 Donald Street

Kind of Pipe

Size

Size of Main

~~Repair~~ ~~Renewal~~ New Service

Com. 11-6-50

Location

Date	Material	Amount	Total	Date	Amount
Sept. 9, '50	Labor	2 60	2 60	Aug 19 '50	31 00
	10% Overhead		26	1/15 9 '50	3 23
	36' - 3/4" Copper Tubing @.275		9 90		31 27
	1 - 3/4" C x 1/2" I.W.H. S&W		3 76	Sept. 9, '50	Labor
	Littlefield Shovel 2 hrs. @7.00	14 00	14 00	24' - 3/4" Copper tubing @.275	6 60
	Trucking 1 hr. @.75		75	1 - 3/4" Corp-cock	3 60
			31 27	1 - 3/4" C x 3/4" Curb-cock	4 40
				1 - Box & Rod	3 35
				1 - 1/2" Offset Tail Piece	42
				1 - 1/2" Straight Tail Piece	42
				Littlefield Shovel 2 hrs. @7.00	14 00
				Trucking 1 hr. @.75	75
	Labor				43 34

*Deposited*  
*1/15 9 '50*  
*3 23*  
No Charge

Hadley Press, Inc., Lexington

DATE \_\_\_\_\_

# TOWN OF LEXINGTON—BOARD OF PUBLIC WORKS

## WATER DIVISION

The undersigned applies for a supply of water at No. \_\_\_\_\_ St. and hereby agrees to comply with the rules and regulations as now, or at any future time, established by the Board of Selectmen.

Am't. of Estimate \$ \_\_\_\_\_


Owner \_\_\_\_\_

Am't. Paid \$ \_\_\_\_\_

Address \_\_\_\_\_

Builder \_\_\_\_\_

Sketch of Service Here

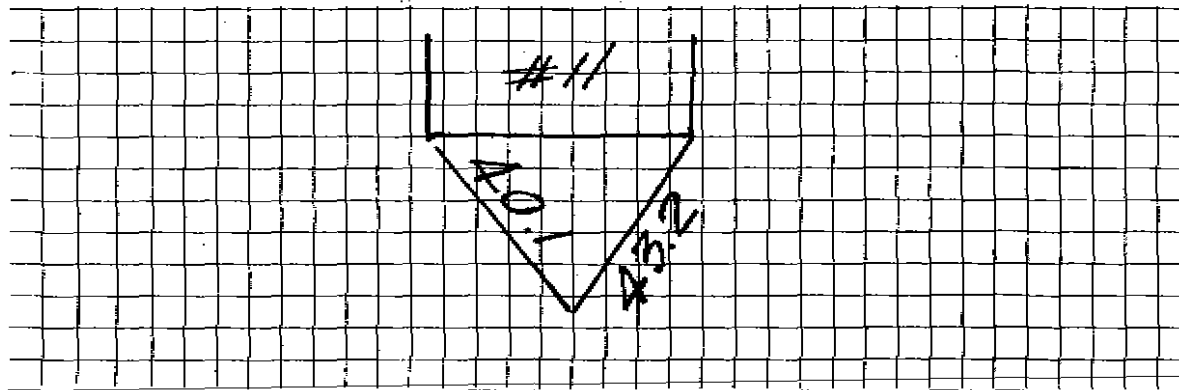

Connection made in \_\_\_\_\_ Street.

Work completed \_\_\_\_\_ 19

Remarks: