

Name William Marchi

Service No. 91

Address 13 Donald Street

1943

Lexington, Mass.

Location 13 Donald Street

Kind of Pipe

Size

Size of Main

~~Repair - Renewal~~ New Service

Com. 5-29-50

Location

Date	Material	Amount	Total	Date	Location	Amount
May 18, '50	Labor	2 45	2 45	May 18 '50	Deposited	4 00
	10% Overhead		25	July 8 '50	Refunded	17 06
	40' - 3/4" Copper Tubing @.23	9 20			No Charge	22 94
	1 - 3/4" C x 1/2" I.W.H. S&W	3 29		May 18, '50	Labor	2 45
	Littlefield Shovel 1 hr. @ 7.00	7 00	7 00	22' - 3/4" Copper Tubing @.23		5 06
	Trucking 1 hr. @.75		75	1 - 3/4" C Corp-cock		3 15
			22 94	1 - 3/4" C x 3/4" C Curb-cock		3 85
				1 - Box & Rod		3 60
				1 - 1/2" Straight Tail Piece		38
				1 - 1/2" Offset Tail Piece		38
				Littlefield Shovel 1 hr. @ 7.00		7 00
				Trucking 1 hr.		75
	Labor					26 62

DATE _____

TOWN OF LEXINGTON - BOARD OF PUBLIC WORKS

WATER DIVISION

The undersigned applies for a supply of water at No..... St. and hereby agrees to comply with the rules and regulations as now, or at any future time, established by the Board of Selectmen.

Am't of Estimate \$.....

Owner


Am't Paid \$.....

Address

Builder

.....

Sketch of Service Here

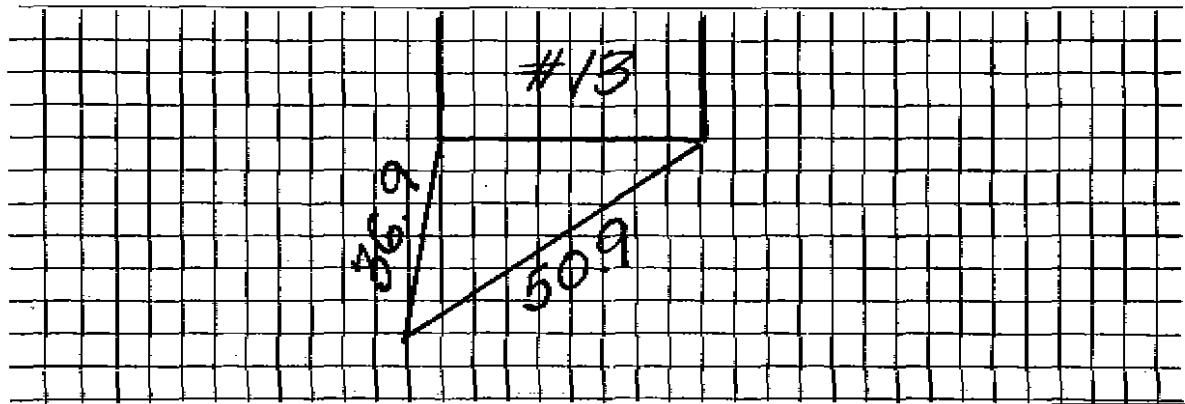

Connection made in Street.

Work completed19

Remarks: