

Name William Marchi
 Address 15 Donald Street
 Lexington, Mass.

Service No. 91

Location 15 Donald Street

Kind of Pipe Size Size of Main
~~XXXXXXXXXXXX~~—New Service Com. 5-29-50 Location

Date	Material	Amount	Total	Date	Material	Amount
May 18, '50	Labor	2 45	2 45	May 18 '50	Labor	4 00
	10% Overhead		25	Jan 8 '50	Refunded	12 17
	40' - 3/4" Copper Tubing @.23	9 20	9 20		No Charge	27 83
	1 - 3/4" C x 1/2" I.W.H. S&W	3 29	3 29	May 18, '50	Labor	2 45
	1 - 3/4" C x 3/4" C Union (3pts)	1 39	1 39	22' - 3/4" Copper Tubing @.23		5 06
	Littlefield Shovel 1 1/2 hrs. @ 7.00	10 50	10 50	1 - 3/4" C Corp-cock		3 15
	Trucking 1 hr. @.75		75	1 - 3/4" C x 3/4" C Curb-cock		3 85
			27 83	1 - Box & Rod		3 60
				1 - 1/2" Offset Tail Piece		38
				1 - 1/2" Straight Tail Piece		38
				Littlefield Shovel 1 hr. @ 7.00		7 00
				Trucking 1 hr. @.75		75
	Labor					26 62

DATE _____

TOWN OF LEXINGTON - BOARD OF PUBLIC WORKS
WATER DIVISION

The undersigned applies for a supply of water at No. St. and hereby agrees to comply with the rules and regulations as now, or at any future time, established by the Board of Selectmen.

Am't of Estimate \$.....

Owner


Am't Paid \$.....

Address

Builder

.....

Sketch of Service Here

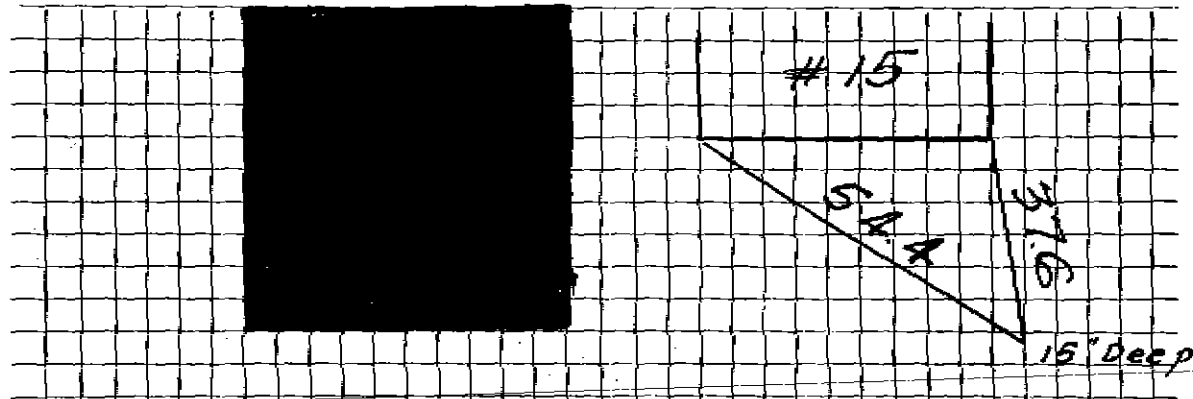

Connection made in Street.

Work completed19

Remarks: