

WATER SERVICE RECORD

4881

Name Terry Fratus

Service No. 120

Address 18 Donald ST

Location Lexington

~~Repair~~ ~~Reinstall~~ - New Service

Com. 8-10-53


Date	Material	Amount	Total	Date	Amount
7/6/53	Labor	1 75		6-2-53	Deposited 25 00
	10% overhead	18	1 93	8-10-53	Refunded 25 00
	42'-3/4" Copper Tubing @.3629	15 24			NON CHARGE 21 92
	1-3/4" C x 1/2 I.W.H. STOP & WASTE	4 00	7/6/53	Labor	1 75
	1 Hr. Trucking		75	16'-3/4" Copper Tubing @.3629	5 80
			21 92	1-3/4" C. Corp-cock	4 33
				1-3/4" C x 3/4" C. Curb-cock	4 67
				1-Box & Rod	3 90
				1-1/2 offset tail piece	50
				1-1/2 straight tail piece	50
				1 Hr. Trucking	75
					22 20

TOWN OF LEXINGTON - BOARD OF PUBLIC WORKS

WATER DIVISION

DATE _____

Sketch of Service Here

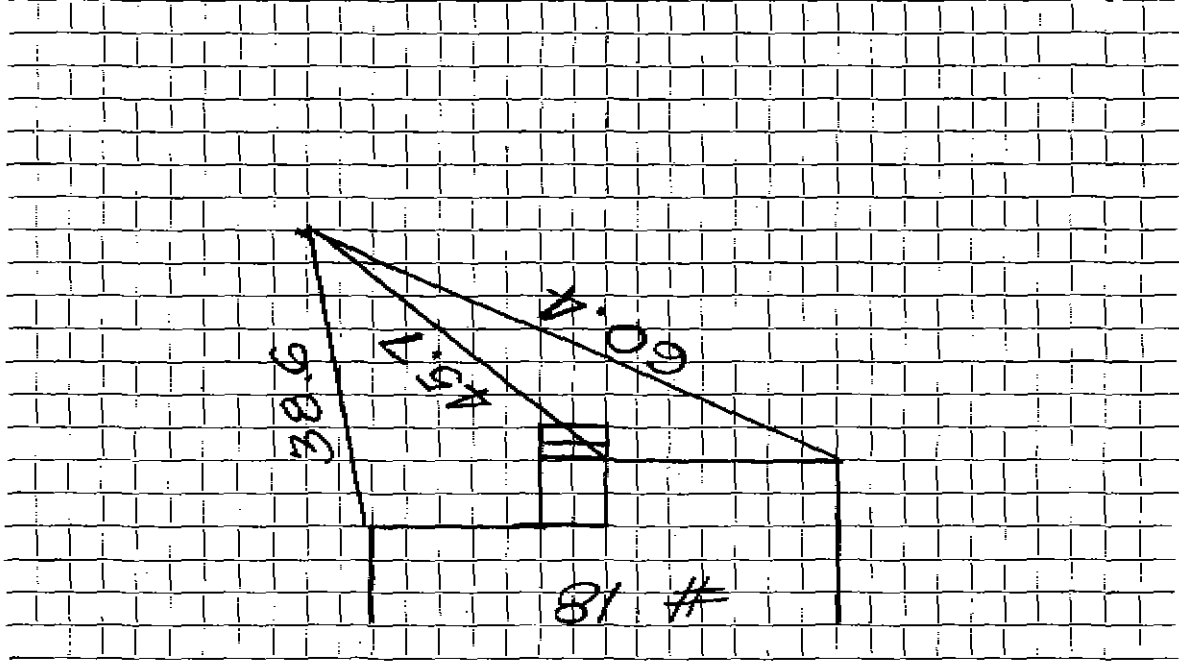

Connection made in _____

Street _____

Work completed _____

Remarks: _____

