




DATE 3-9-12

TOWN OF LEXINGTON — BOARD OF PUBLIC WORKS  
WATER DIVISION

Sketch of Service Here

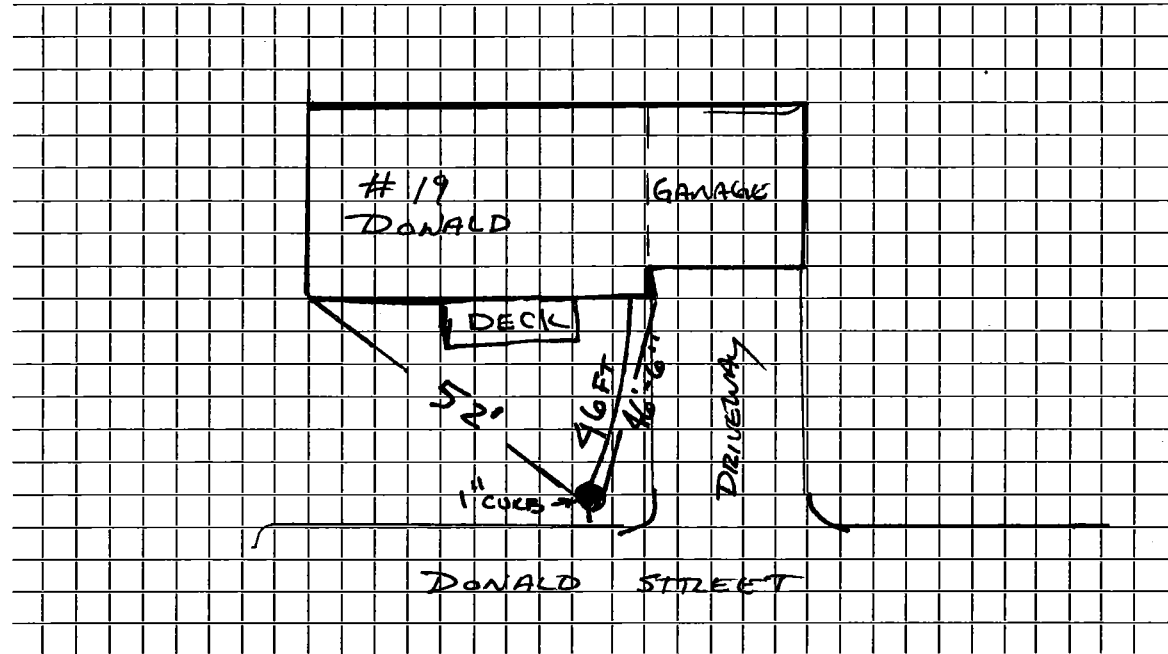

Connection made in ..... Street. Work completed ..... TO.

Remarks: A. Balderson 3/4" CURB - ADDED NEW 1" CURB STOP TO HOUSE 1" 3/4" 1" 3/4" TO STREET