

Name K. V. Wolsey
 Address 24 Donald Street
 Lexington, Mass.

Service No.

2487
 #5096

Kind of Pipe

Location

Size of Main

~~Repair - New Service~~ New Service

Location

Date	Material	Amount	Total	Date	Location	Amount
Oct. 15, '48	Labor	3 15	3 15	Oct 13 '48	<i>Adjusted</i> <i>Refunded</i>	20 00
	10% Overhead		32	Dec 31 '48		3 49
	28'-3/4" Copper Tubing @ .255		7 14		Non-charge	21 51
	1-3/4" C. x 1/2" I.W.H. S & W		3 15	Oct. 16, '48	Labor	4 40
	1 hr. Littlefield Shovel		7 00		12'-3/4" Copper Tubing	3 06
	1 hr. Trucking		75		1-3/4" C. Corp-cock	3 00
			21 51		1-3/4" C x 3/4" C. Curb-cock	3 68
					1-Box & Rod	3 55
					1 hr. Littlefield Shovel	7 00
					1-1/2" Offset Tail Piece	30
					1-1/2" Straight Tail Piece	30
					1 hr. Trucking	75
	Labor					26 04

Hadley Press, Inc., Lexington

DATE _____

TOWN OF LEXINGTON—BOARD OF PUBLIC WORKS

WATER DIVISION

The undersigned applies for a supply of water at No. 1 St. and hereby agrees to comply with the rules and regulations as now, or at any future time, established by the Board of Selectmen.

Am't. of Estimate \$ _____


Owner _____

Am't. Paid \$ _____

Address _____

Builder _____

Sketch of Service Here

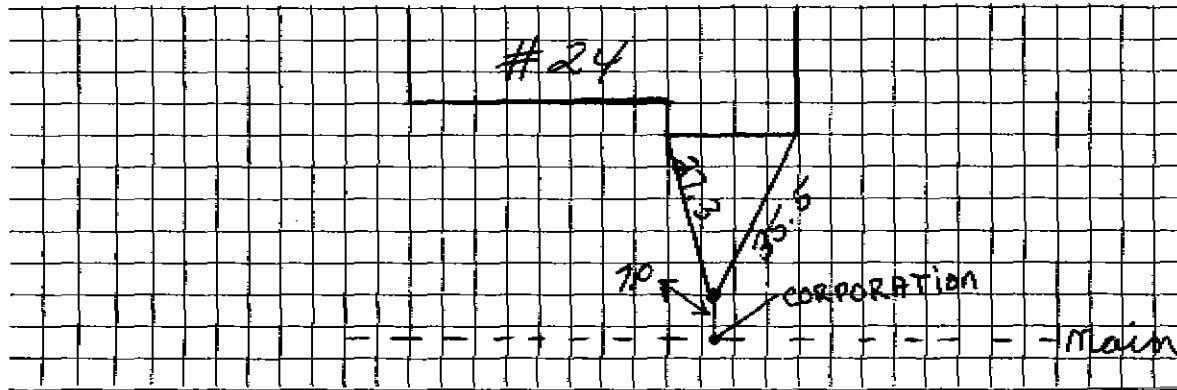

Connection made in _____ Street.

Work completed _____ 19

Remarks: