

Name Augustine Arsenault

Service No. 179

Address 25 Donald Street

#6738, 7212

Lexington, Mass.

Location 25 Donald Street

Kind of Pipe

Size

Size of Main

Repair-Renewal-New Service

Location

Date	Material	Amount	Total	Date	Location	Amount
Sept. 2, '48	Labor	3 40	3 40	Sept. 1, '48	Deposited	35 00
	10% Overhead		34	Oct. 21 '48	Refunded	10 95
	31' - 3/4" Copper Tubing @.255	7 91			Non-charge	24 05
	1 - 3/4" C x 1/2" I.W.E. S & W	3 15		Sept. 2, '48	Labor	1 40
	Littlefield Shovel 1 hr. @ 7.00	7 00		26' - 3/4" Copper Tubing @.255		6 63
	Allis-Chalmers Tractor 1/2 hr. @ 3.00	1 50		1 - 3/4" C Corp-cock		3 00
	Trucking 1 hr. @.75		75	1 - 3/4" C x 3/4" C Curb-cock		3 68
			24 05	1 - Box & Rod		3 55
				1 - 1/2" Offset Tail Piece		30
				1 - 1/2" Straight Tail Piece		30
				Trucking 1 hr. @.75		75
						19 61
	Labor					

Ordn 10/25/48

Hadley Press, Inc., Lexington

DATE \_\_\_\_\_

# TOWN OF LEXINGTON—BOARD OF PUBLIC WORKS WATER DIVISION

The undersigned applies for a supply of water at No. \_\_\_\_\_ St. and hereby agrees to comply with the rules and regulations as now, or at any future time, established by the Board of Selectmen.

Am't. of Estimate \$ \_\_\_\_\_


Owner \_\_\_\_\_

Am't. Paid \$ \_\_\_\_\_

Address \_\_\_\_\_

Builder \_\_\_\_\_

Sketch of Service Here

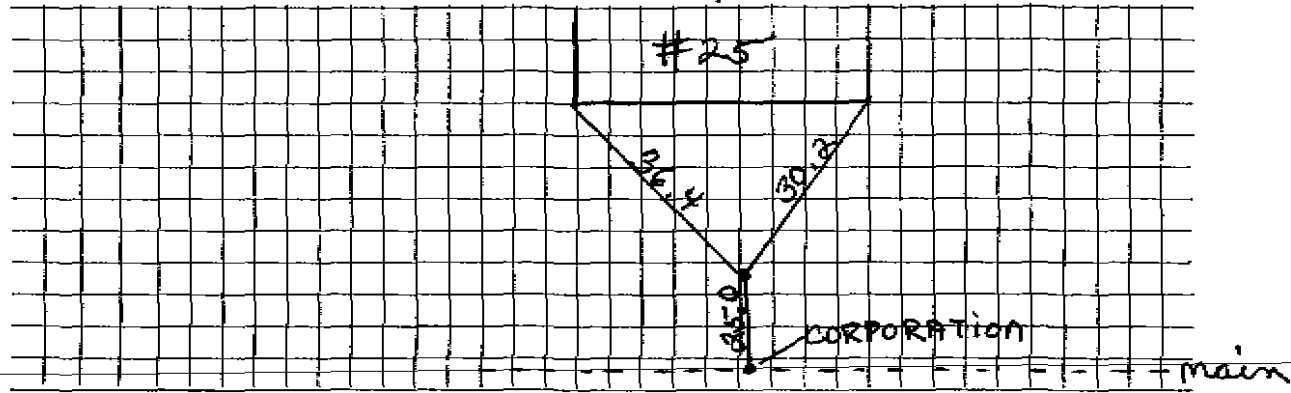

Connection made in \_\_\_\_\_ Street. Work completed \_\_\_\_\_ 19

Remarks: