

WATER SERVICE RECORD

#7711 23

Name; Albert L. Hildbrand

Service No. 35

Address 26 Donald Street

#6871

Location

~~Renewal~~ New Service


Com 5-3-54

Date	Material	Amount	Total	Date	Amount
3/10/54	Labor	1 75		3-3-54	Deposited 25 00
	10% overhead	18	1 93	3-4-54	Refunded (7 12
	32'-3/4" copper tubing @.35		11 20		NON CHARGE 17 88
	1-3/4 Cx 1/2 I.W.H. Stop & waste		4 00	3/10/54	Labor 1 75
	1 hr. trucking		75		10' 3/4" copper tubing @.35 3.50
			17 88		1-3/4" C Corp cock 4 33
					1 - 3/4" curb cock 4 87
					1- Box & rod 3 90
					1 1/2 Straight tail piece 50
					1-1/2 offset tail piece 50
					1 hr trucking 75
					19 90

DATE _____

TOWN OF LEXINGTON — BOARD OF PUBLIC WORKS
WATER DIVISION

Sketch of Service Here

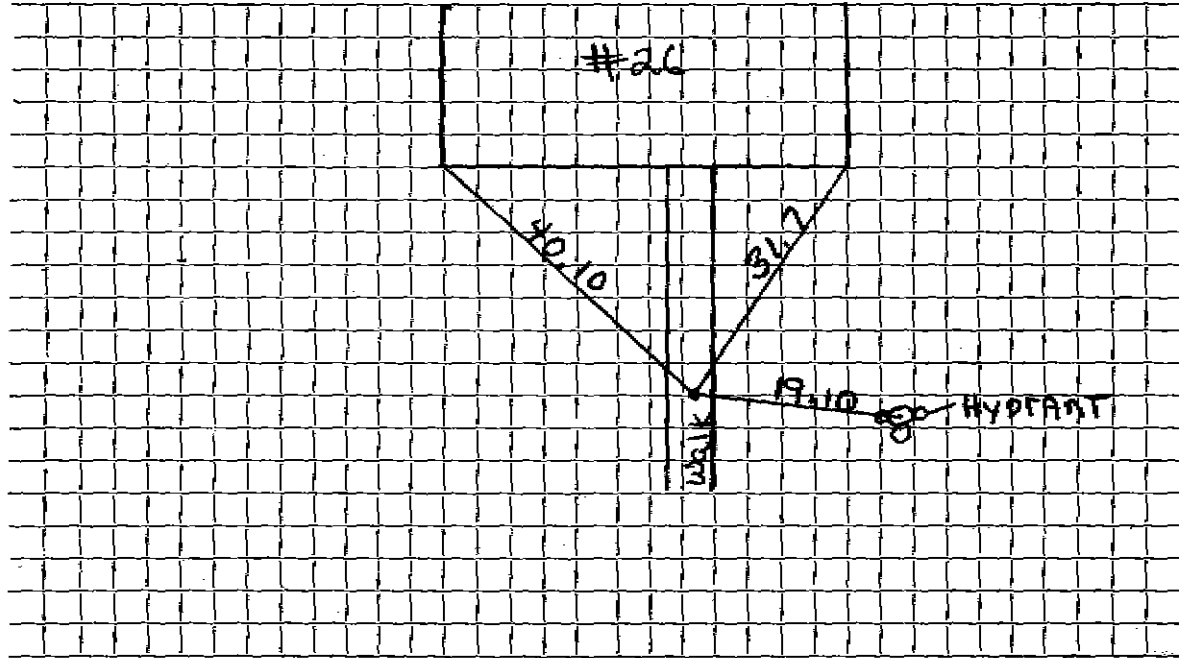

Connection made in _____ Street. Work completed

Remarks:

.....

.....