

Name John Callahan

Service No. 291

Address 30 Donald Street
Lexington, Mass.

3399

Location

Kind of Pipe

Size

Size of Main

~~Repair~~ ~~Renewal~~ - New Service

Location

Date	Material	Amount	Total	Date	Location	Amount
Nov. 2, '48	Labor	1 05	1 05	Dec 20 '48	Hydrant	30 00
" 3 "	"	3 25	3 25	Dec 21 '48	Expended	5 44
	10% Overhead		43		Non charge	24 56
	35'-3/4" Copper Tubing @ .255	8 93	8 93	Nov. 3, '48	Labor	3 25
	1-3/4" C x 1/2" I.W.H. S&W	3 15	3 15		1-3/4" Copper Tubing @ .255	2 30
	1 hr. Littlefield Shovel	7 00	7 00		1-3/4" C. Corp-cock	3 00
	1 hr. Trucking		75		1-3/4" C x 3/4" C. Curb-cock	3 68
			24 56		1-Box & Rod	3 55
					1-1/2" Offset Tail Piece	30
					1-1/2" Straight Tail Piece	30
					1 hr. Trucking	75
	Labor					17 13

DATE _____

TOWN OF LEXINGTON - BOARD OF PUBLIC WORKS

WATER DIVISION

The undersigned applies for a supply of water at No. St. and hereby agrees to comply with the rules and regulations as now, or at any future time, established by the Board of Selectmen.

Am't of Estimate \$.....


Owner

Am't Paid \$.....

Address

Builder

Sketch of Service Here

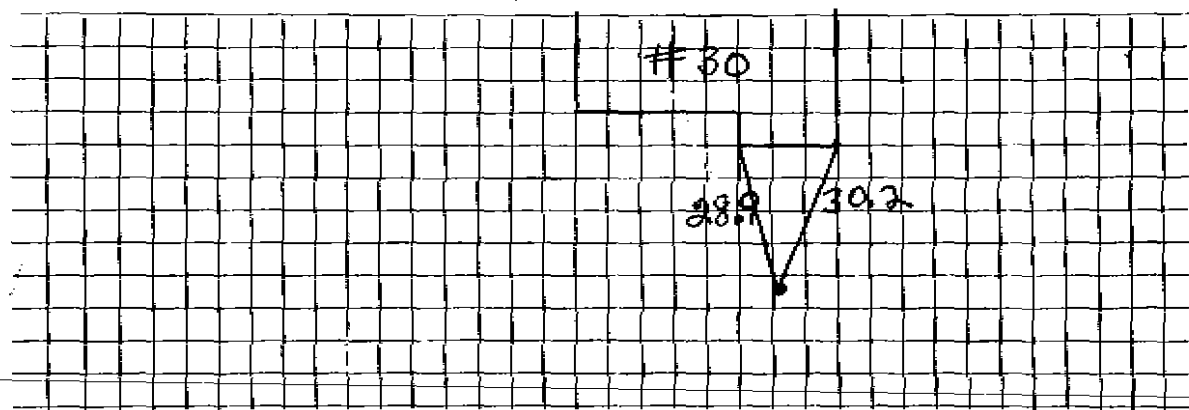

Connection made in Street.

Work completed19

Remarks: