

WATER SERVICE RECORD

1387

Name Eric Sahlberg

Service No. 374

Address 1/2 Donald St.

#7077

Location Lexington

6856

~~REPAIR SERVICE~~ - New Service


Comm. 12-21-53

Date	Material	Amount	Total	Date	Amount
12/2/53	Labor	1 75		11-17-53 Deposited	25 00
	10% overhead	18	1 93	12-21-53 Refunded	(4 89
	37'-3/4" Copper tubing @.3629	13 43		NON CHARGE	20 11
	1-3/4" C x 1/8" I.W.H. STOP & WASTE	4 00		12/2/53 Labor	1 75
	1 Hr. Trucking	75	20 11	28'-3/4" Copper tubing @.3629	10 16
				1-3/4" C. Corp-cock	4 33
				1-3/4" C x 3/4" C. Curb-cock	4 67
				1-Box & Rod	3 90
				1-1/2 straight tail piece.	50
				1-1/2 offset tail piece	50
				1 Hr. Trucking	75
					<u>26 56</u>

TOWN OF LEXINGTON — BOARD OF PUBLIC WORKS

WATER DIVISION

Sketch of Service Here

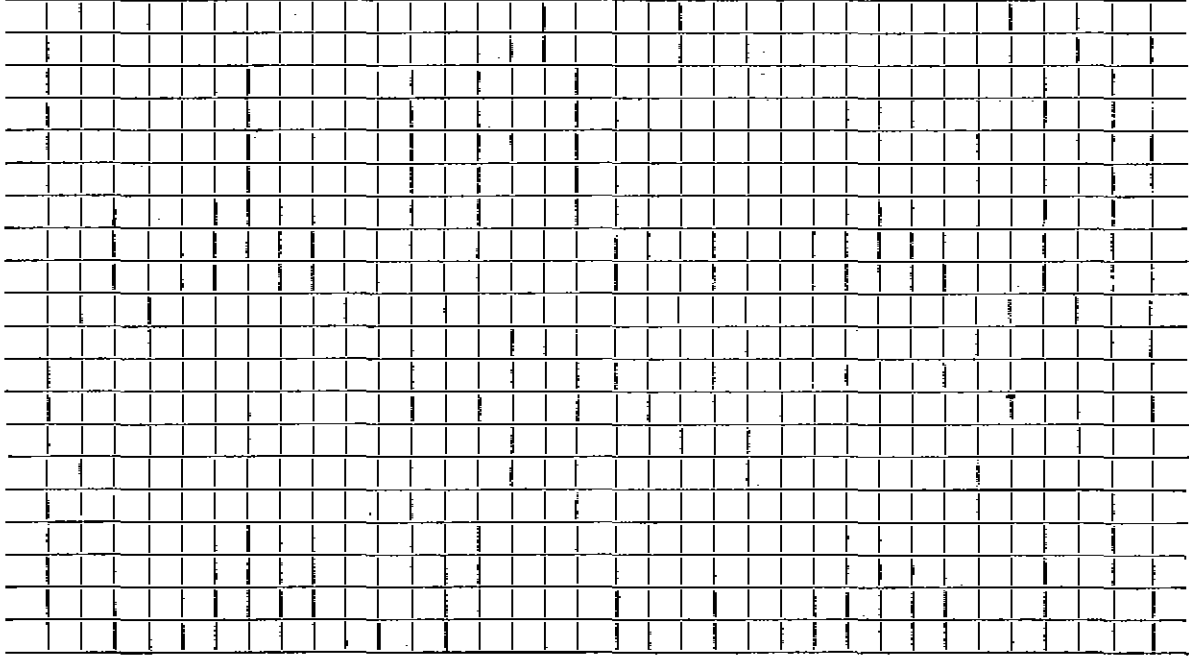

Connection made in Street. Work completed

Remarks:

.....
.....
.....

WATER SERVICE RECORD

1387

Name Eric Sahiberg

Service No. 374

Address 4 Donald St.

#7077

Location Lexington

6856

~~Repair~~ ~~Revised~~ New Service

Com. 12-21-53

Date	Material	Amount	Total	Date	Amount
12/2/53	Labor	1 75		11-17-53 Deposited	25 00
	10' overhead	10	1 93	12-21-53 Refunded	(4 89
	37' 3/4" Copper tubing @ .3529	13 43		NON CHARGE	20 11
	1-3/4" 2 x 1/2 T.Y.F. STOP & WASTE	1 00		12/2/53 Labor	1 75
	1 Hr. Trucking		75	28' 3/4" Copper tubing @ .3529	10 16
			20 11	1-3/4" C. Corp-cock	1 33
				1-3/4" C x 3/4" C. Corp-cock	1 67
				1-Box & Rod	3 00
				1-1/2 straight tail piece	50
				1-1/2 offset tail piece	50
				1 Hr. Trucking	75
					<u>25 56</u>

DATE _____

TOWN OF LEXINGTON — BOARD OF PUBLIC WORKS

WATER DIVISION

Sketch of Service Here

A large grid of graph paper, consisting of approximately 20 columns and 20 rows, intended for sketching service details.

Connection made in Street. Work completed

Remarks:
.....
.....