

WATER SERVICE RECORD

Name **Charles H. Murray**

Service No. **1**

Address **6 Donald Street**

Location

~~REPAIR SERVICE~~ - New Service

Com. 2-8-54


Date	Material	Amount	Total	Date	Amount
1/27/54	Labor	1 75		1-4-54	Deposited 25 00
	10% overhead	18	1 93	2-8-54	Refunded 6 71
	32' - 3/4" copper tubing @ .3629	11 61			<u>NON CHARGE</u> 10 29
	1 - 3/4" C x 1/2 I.W.H. stop & waste	4 00	4 00	1/27/54	Labor 1 75
	1 hr. trucking		75		10' - 3/4" copper tubing @ .3629 3 63
			18 29		1 - 3/4" C. corp-cock 4 33
					1 - 3/4" C x 3/4" C curb-cock 4 67
					1 box and rod 3 90
					1 - 1/2 offset tail pc. 50
					1 - 1/2 straight tail pc. 50
					1 hr. trucking 75
					<u>20 03</u>

TOWN OF LEXINGTON — BOARD OF PUBLIC WORKS

WATER DIVISION

DATE _____

Sketch of Service Here

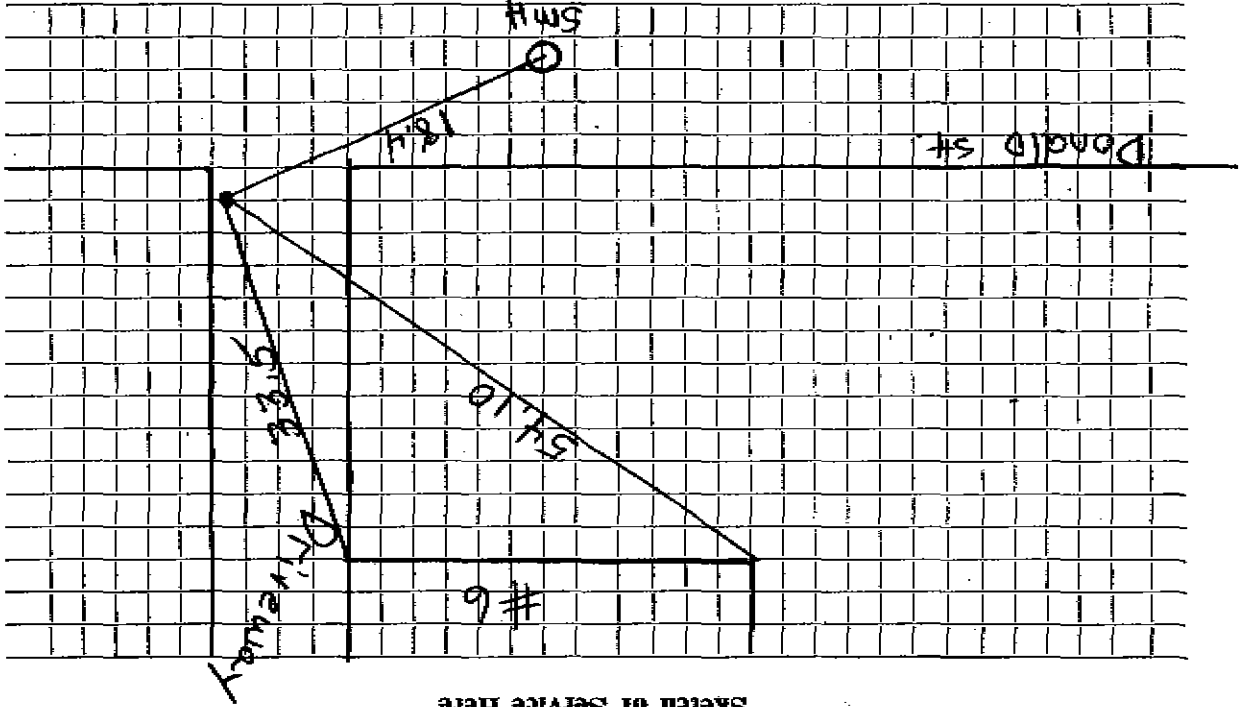

Connection made in _____ Street.

Work completed _____

Remarks: _____