

WATER SERVICE RECORD

#5159

Name Joseph F. McCormick

Service No. 6

Address 9 Donald St.

Location


~~Repair~~ ~~Renewal~~ New Service

Com. 4-11-55

Date	Material	Amount	Total	Date	Amount
3/9/55	Labor	1 85		1-13-55	Deposited 25 00
	10% overhead	19	2 04	4-11-55	Refunded (5 26
	37' - 3/4" copper tubing @ .35	12 95			NON CHARGE 19 74
	1 -3/4"C x 1/2 I.W.R. stop & waste	4 00		3/9/55	Labor 1 85
	1 hr. trucking		75	15' - 3/4" copper tubing @ .35	5 25
			19 74	1 -3/4"C. corp-cock	4 33
				1 -3/4"C. curb-cock	4 67
				1 box and rod	3 90
				1 -1/2 straight tail pc.	50
				1 -1/2 offset tail pc.	50
				2-2/3 hrs. Littlefield shovel @ 7.50	20 00
				1 hr. trucking	75
					41 75

WATER DIVISION

Sketch of Service Here

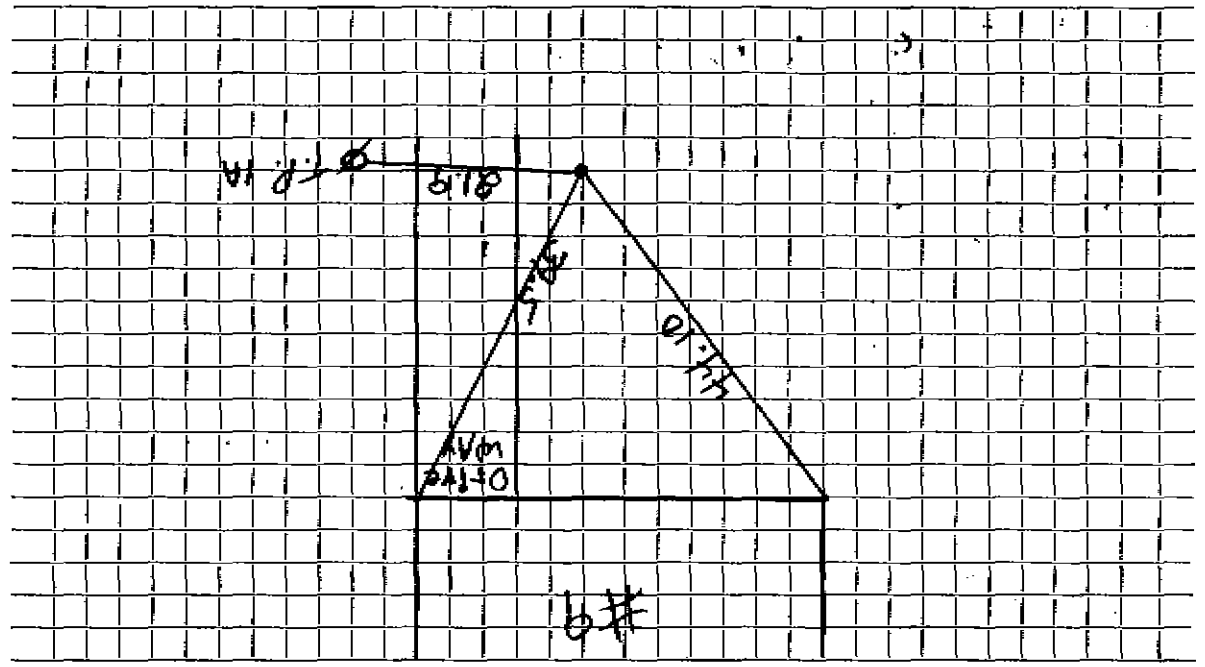

Connection made in _____

Street _____

Work completed _____

Remarks: _____

