
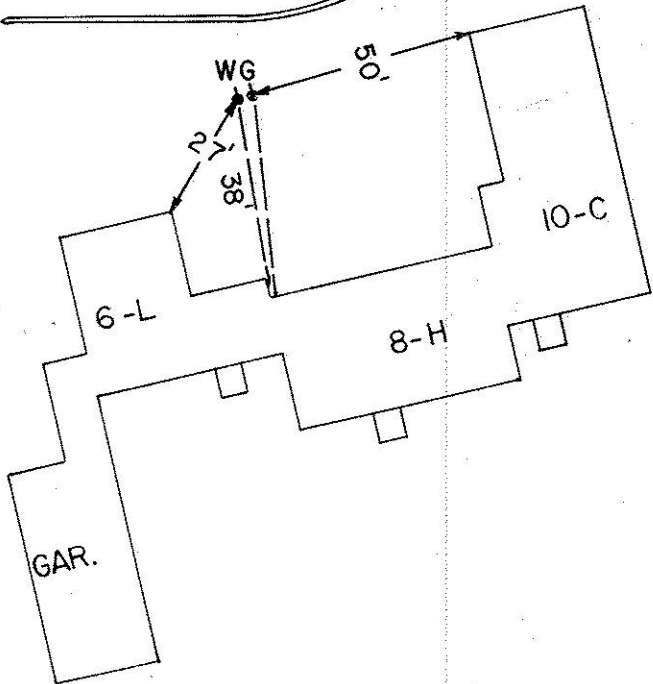
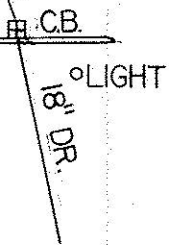


APPROXIMATE

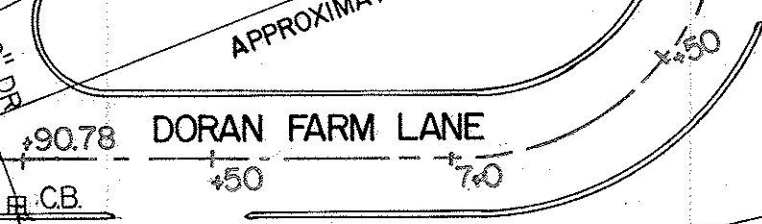

GAR.

GAR.

6-L

8-H

10-C

WG

38

50'

90.78

50

70

x 50

CB.

18" DR.

18" DR.

° LIGHT