

## WATER SERVICE RECORD

Name Wynwood Associates

Service No. 136

Address 11 Douglas Road (78 Hill St., Lex.)

# 7180

Location Lot #28 Sta. 8+07

~~Repair~~ ~~Renewal~~ - New Service


Comm 12-4-61

Date	Material	Amount	Total	Date	Amount	
10/2/61	Labor	4 53		9-26-61	Deposit	100 00
	10% O.H.	45	4 98	12-4-61	Refund	48 16
84'	3/4" Copper Tubing @ .42		35 28			51 84
1	3/4" Cx 1/2 IWH Stop & Waste		6 17		NO CHARGE	
1	3/4" C3 part Union @ 2.41		2 41	8-18-60	Labor	3 63
1	Hrs. Trucking @ 3.00		3 00		10' 3/4" Copper tubing @ .42	4 20
			51 84		1 3/4" G Corp Cock	4 91
					1 3/4" C Curb Cock	6 28
					1 Box & Rod	4 90
						23 92
					1 1/2 Offset tailpiece	50
					1 1/2 Straight Tailpiece	50
						24 92

DATE \_\_\_\_\_

**TOWN OF LEXINGTON — BOARD OF PUBLIC WORKS**  
**WATER DIVISION**

Sketch of Service Here

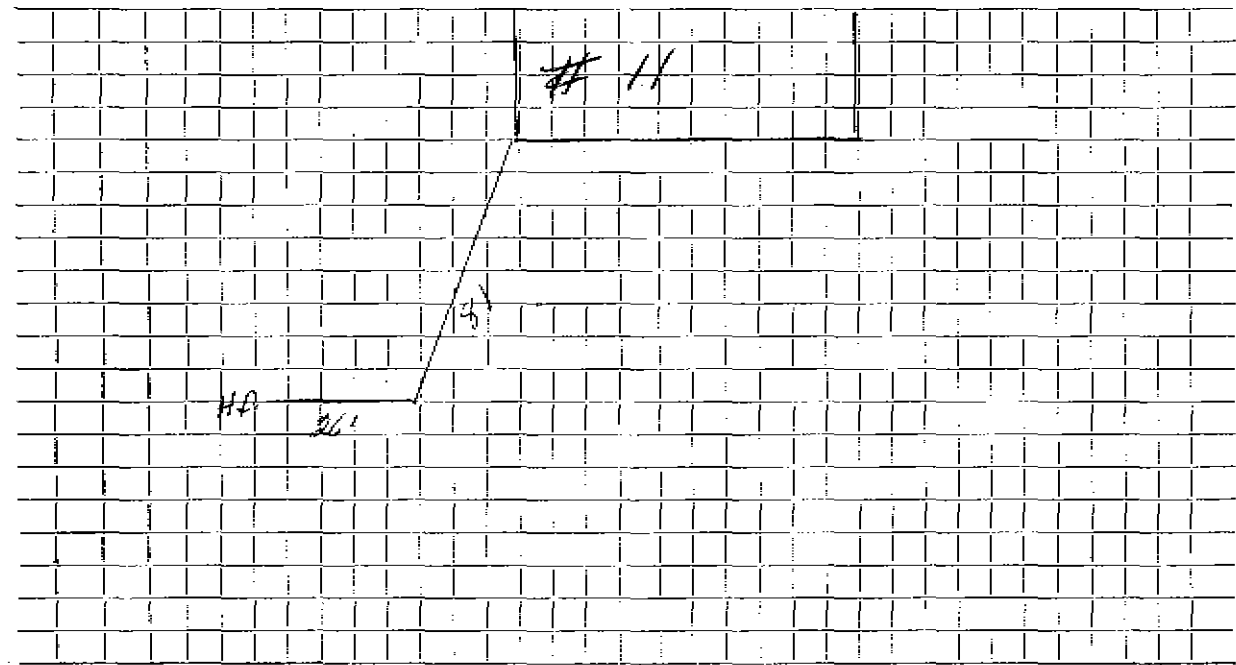

Connection made in ..... Street. Work completed .....

Remarks: .....  
.....  
.....