

WATER SERVICE RECORD

Name Wynwood Associates, Inc.

Service No. 11

Address ¹⁴
~~12~~ Douglas Road

Location Lot #34 Sta. 8+99


~~Repair & Renewal~~ — New Service

Comm 3-8-61

Date	Material	Amount	Total	Date		Amount
3-30-61	Labor	2.00		3-31-61	<i>Deposit</i>	140.00
	10% C.H.	.20	2.20	5-8-61	<i>Retain</i>	59.37
58'	3/4" Copper tubing @.42		24.36			40.63
1	3/4" x 1/2 I.D.H. Stop & Waste		6.17		NON CHARGE	
1	Box & Rod		4.90	8-18-60	Labor	9.08
1	hr. Trucking @3.00		3.00	25'	3/4" Copper tubing @.42	10.50
			40.63	1	3/4" C Corp Cock	4.91
				1	3/4" C Curb Cock	6.28
				1	Box & Rod	4.90
						35.67
				1	1/2 Straight tailpiece	.50
				1	1/2 Offset tailpiece	.50
						36.67

TOWN OF LEXINGTON — BOARD OF PUBLIC WORKS
WATER DIVISION

Sketch of Service Here

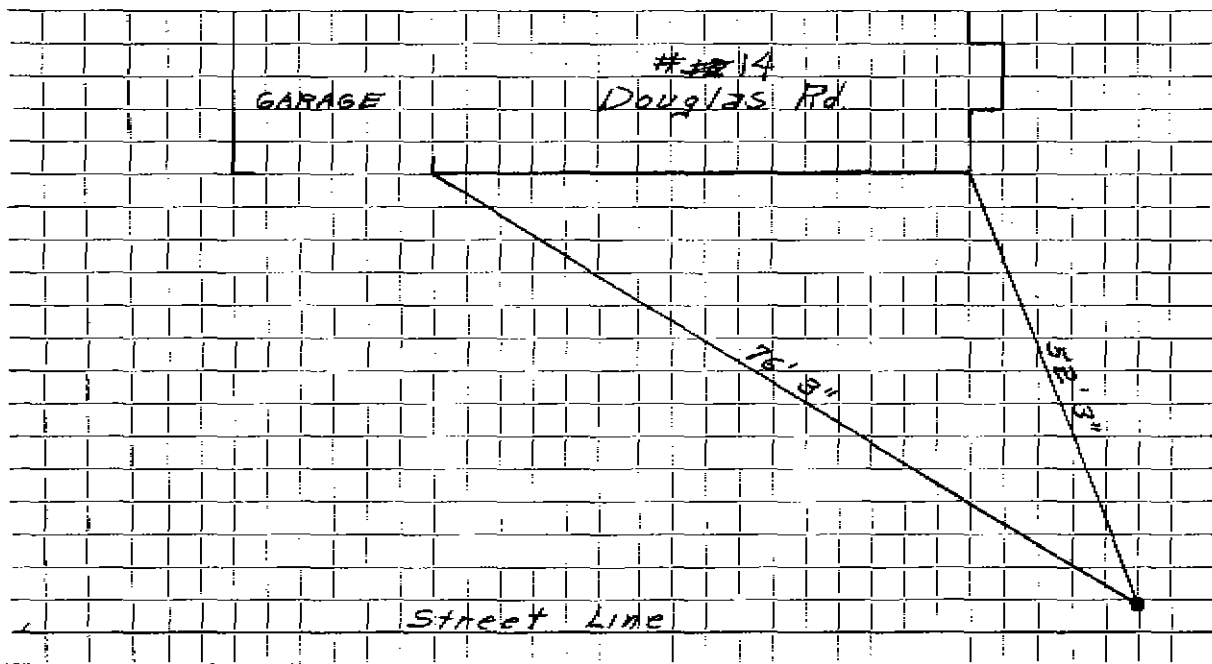

Connection made in Street. Work completed

Remarks:

.....
.....