

WATER SERVICE RECORD

#2965

Name Wynwood Associates

Service No. 12

Address 18 Douglas Road

Location Lot #36 Sta. 12+09

~~Renewal~~ - New Service WO #7079

Comm 5-28-62


Date	Material	Amount	Total	Date		Amount
4/3/62	Labor	8 69		3-27-62	Deposit	169 00
	10% O.H.	87	9 56	5-28-62	Refund	45 26
	80' 3/4" Copper Tubing @ .42		33 60			54 74
	1 3/4" C X 1/2 IWH Stop & Waste		6 17		NO CHARGE	
	1 3/4" C3 Part Union		2 41	8-18-60	Labor	8 71
	1 Hr. Trucking @ 3.00		3 00		24' 3/4" Copper tubing @ .42	10 08
			54 74		1 3/4" C Corp Cock	4 91
					1 3/4" C Curb Cock	6 28
					1 Box & Rod	4 90
						34 88
					1 1/2 Straight Tailpiece	50
					1 1/2 Offset Tailpiece	50
						35 88

DATE _____

TOWN OF LEXINGTON — BOARD OF PUBLIC WORKS

WATER DIVISION

Sketch of Service Here

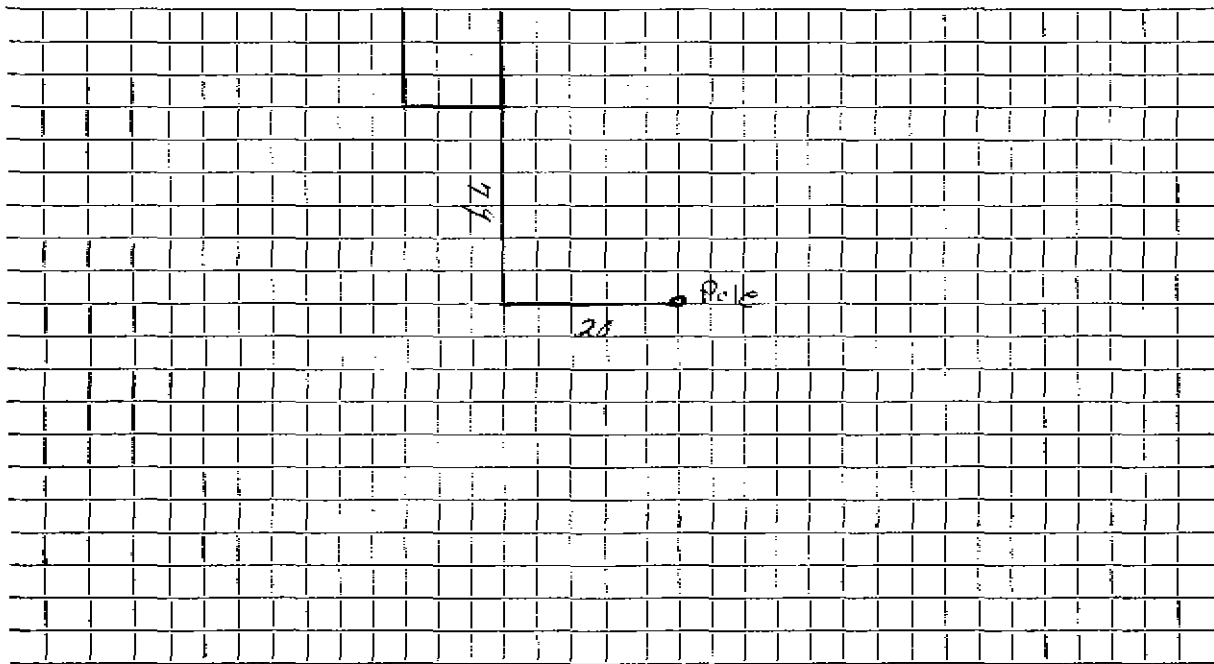

Connection made in Street. Work completed

Remarks:
.....
.....