

WATER SERVICE RECORD

Name Wynwood Associates

Service No. 147

Address 19 Douglas Road

437,7284

Location Lot #25 Sta. 13+17

Repair—Renewal—New Service


Comm. 12-18-61

Date	Material	Amount	Total	Date	Amount
10/5/61	Labor	7 54		10-11-61	100.00
11/15/61	10% O.F.	75	8 29	12-18-61	44 37
	78' 3/4" Copper Tubing @ .42		32 76		55 63
	1 3/4" Cx 1/2 IWH Stop & Waste		6 17		
	1 3/4" C3 Part Union		2 41		
	2 Hrs. Trucking @ 3.00		6 00	8-18-60	Labor 3.63
			55 63		10' 3/4" Copper tubing @ .42 4.20
					1 3/4" C Corp Cock 4.91
					1 3/4" C Curb Cock 6.28
					1 Box & Rod 4.90
				11/15/61	1 1/2 Straight Tailpiece 23.92
					1 1/2 Offset Tailpiece 50
					50
					24 92

DATE _____

TOWN OF LEXINGTON — BOARD OF PUBLIC WORKS
WATER DIVISION

Sketch of Service Here

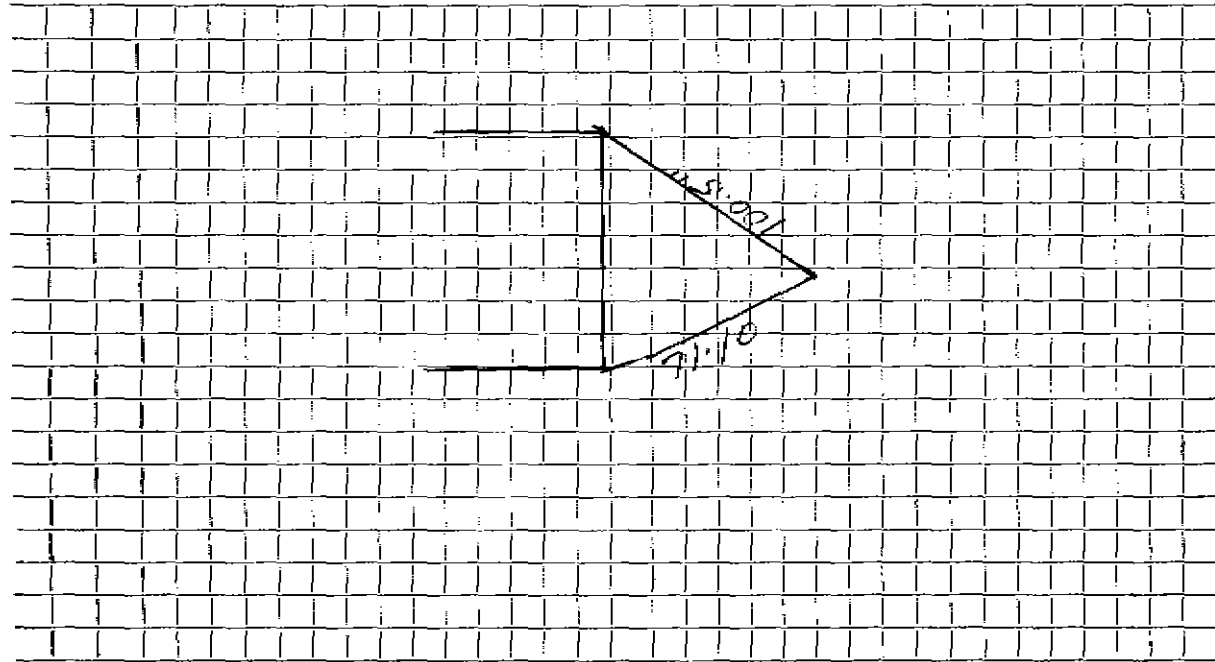

Connection made in Street. Work completed

Remarks:

.....

.....