

WATER SERVICE RECORD

Name Wynwood Associates

Service No. 160

Address 20 Douglas Road (Mail: 78 Hill St.)

Location Lot #37 Sta. 13+64

~~Repair-Renewal~~ - New Service

Comm 12-4-61


Date	Material	Amount	Total	Date		Amount
10/25/61	Labor	7 89		10-11-61	Deposit	100 00
	10% O.H.	79	8 68	12-4-61	Refund	76 14
	80' 3/4" Copper tubing @ .42		33 60			53 84
	1 3/4" Cx 1/2 IWH Stop & Waste		6 17		NON CHARGE	
	1 3/4" C3 part Union		2 41	8-18-60	Labor	9 08
	1 Hr. Trucking @ 3.00		3 00	25'	3/4" Copper tubing @ .42	10 50
			53 86		1 3/4" C Corp Cock	4 91
					1 3/4" C Curb Cock	6 28
					1 Box & Rod	4 90
						35 67
					1 1/2 Straight Tailpiece	50
					1 1/2 Offset Tailpiece	50
						36 67

DATE _____

TOWN OF LEXINGTON — BOARD OF PUBLIC WORKS

WATER DIVISION

Sketch of Service Here

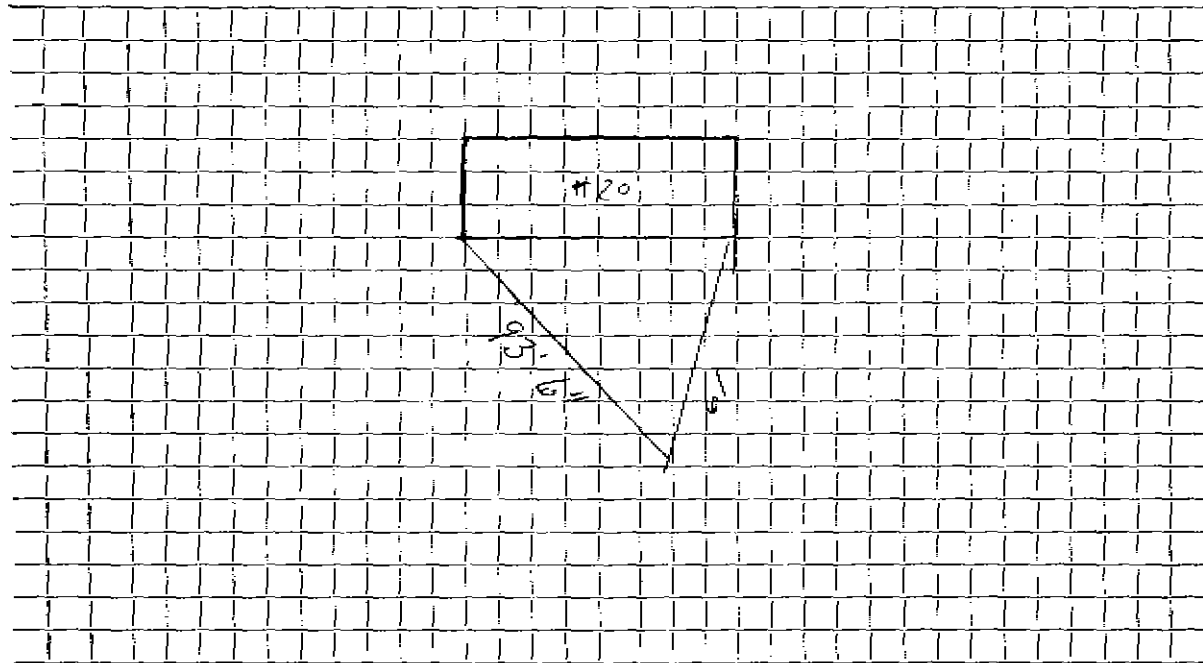

Connection made in Street. Work completed

Remarks:

.....

.....